


N

CENTER

STREET

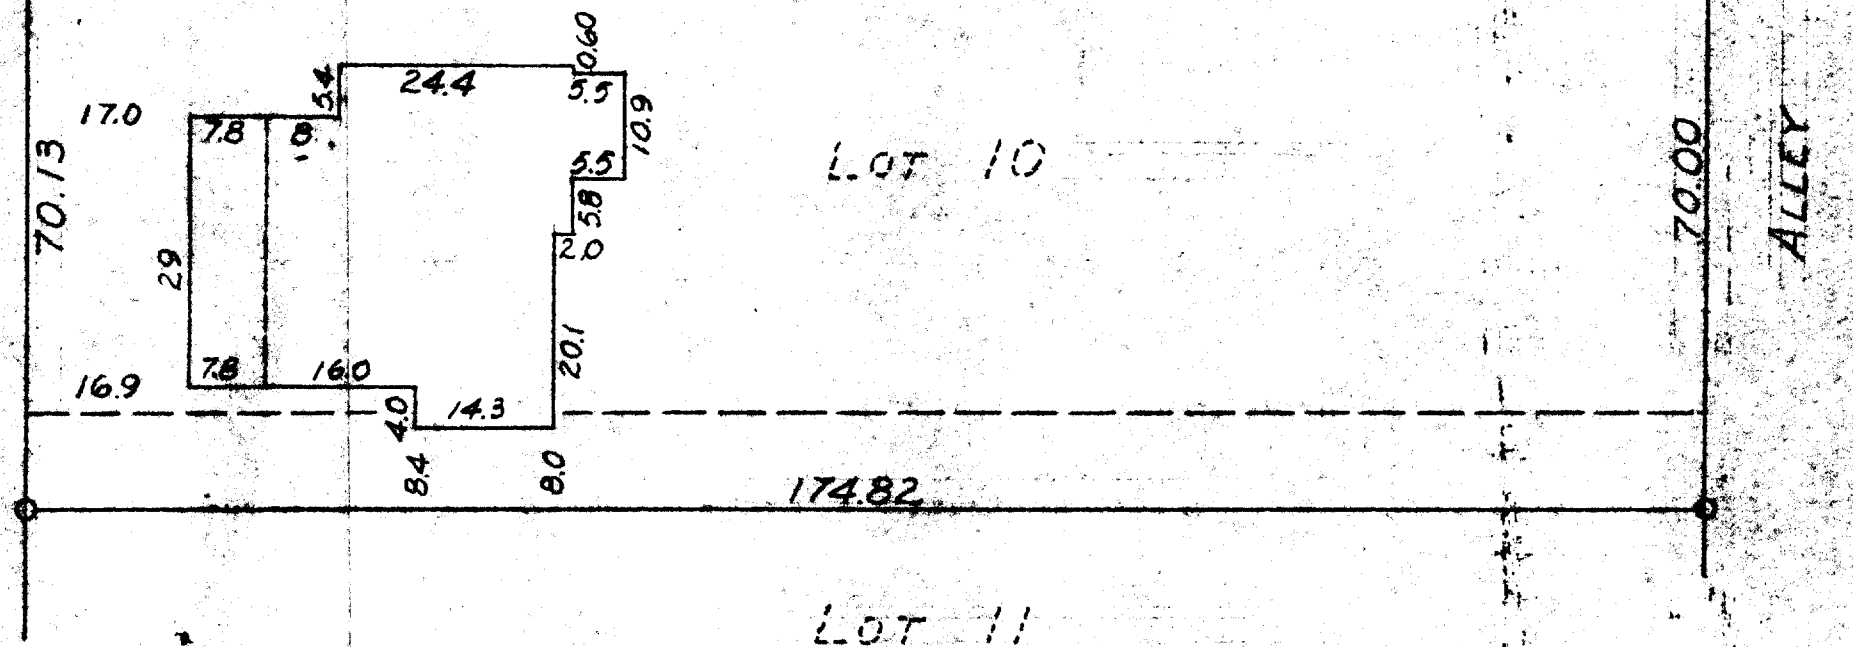

NOTE: THE RECORDED PLAT SHOWS THE EAST-WEST DIMENSION AS 172.00 FEET. IRON PIPES WERE FOUND AT CORNERS OF LOT AT 174.82. AS THERE WAS OVERRUN IN THE BLOCK IN THE EAST-WEST DIRECTION, THE IRON PIPES WERE LEFT AS FOUND.

SCALE ~ 1" = 20'
 O ~ IRON PIPE

STATE OF WISCONSIN }
 WALWORTH COUNTY } SS.

I, GEORGE T. DUNHAM, DO HEREBY CERTIFY THAT I HAVE SURVEYED THE PROPERTY DESCRIBED AS FOLLOWS:
 LOT 10 AND THE NORTH 10 FEET OF LOT 11, ORIGINAL PLAT OF THE CITY OF LAKE GENEVA, WALWORTH COUNTY, WISCONSIN.
 AND THAT THE PLAT SHOWN ABOVE IS A CORRECT REPRESENTATION OF THE PROPERTY LINES AND OF THE IMPROVEMENTS LOCATED THEREON.
 AUGUST 11, 1958

George T. Dunham
 GEORGE T. DUNHAM, SURVEYOR
 DELAVAN, WISCONSIN.

7-72

OP-15