


MAP SCALE 1" = 30'

FARRIS, HANSEN & COOPER, INC.

ENGINEERING, SURVEYING AND LAND PLANNING
715 W. WALWORTH ST. - P.O. BOX 487 - ELKHORN, WI 53121
OFFICE: 414/723-2098

LEGEND

- Ø = IRON PIPE STAKE FOUND 1 1/4"
- = IRON PIPE STAKE SET 1" x 30"
- + = CROSS CUT IN CONCRETE FOUND
- ⊕ = MADE CROSS CUT IN CONCRETE

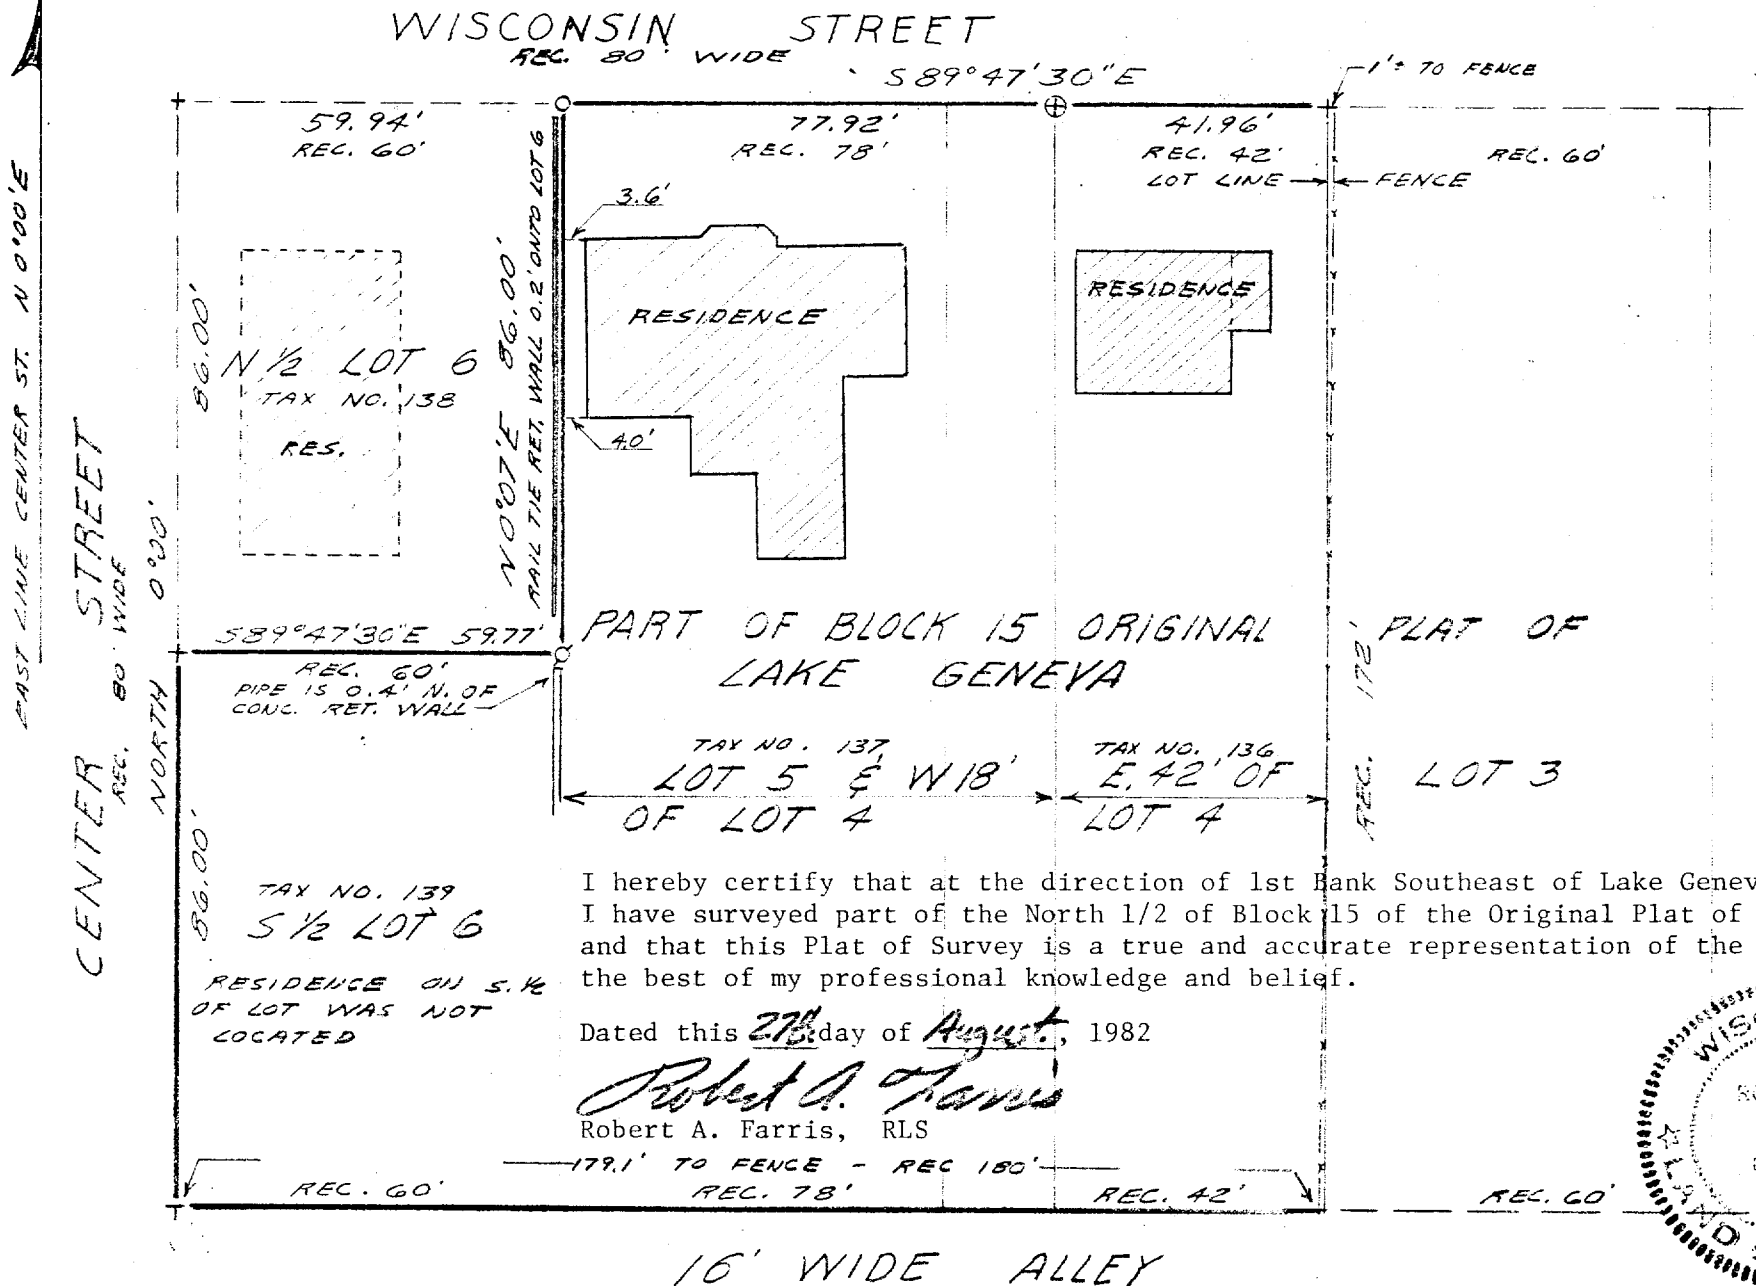


I hereby certify that at the direction of 1st Bank Southeast of Lake Geneva, Owner, I have surveyed part of the North 1/2 of Block 15 of the Original Plat of Lake Geneva, and that this Plat of Survey is a true and accurate representation of the lot lines to the best of my professional knowledge and belief.

Dated this 27th day of August, 1982

Robert A. Farris

Robert A. Farris, RLS

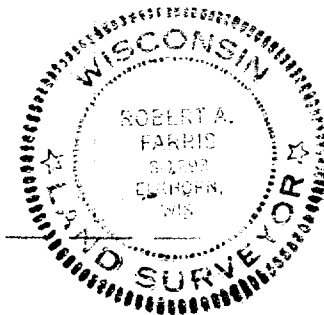

DRAWING NUMBER 1992-B

7-722-F