


17400 W. NORTH AVENUE
BROOKFIELD WISC 53005 PH. (414) 786-1777

DATE: June 24, 1982

5-4382

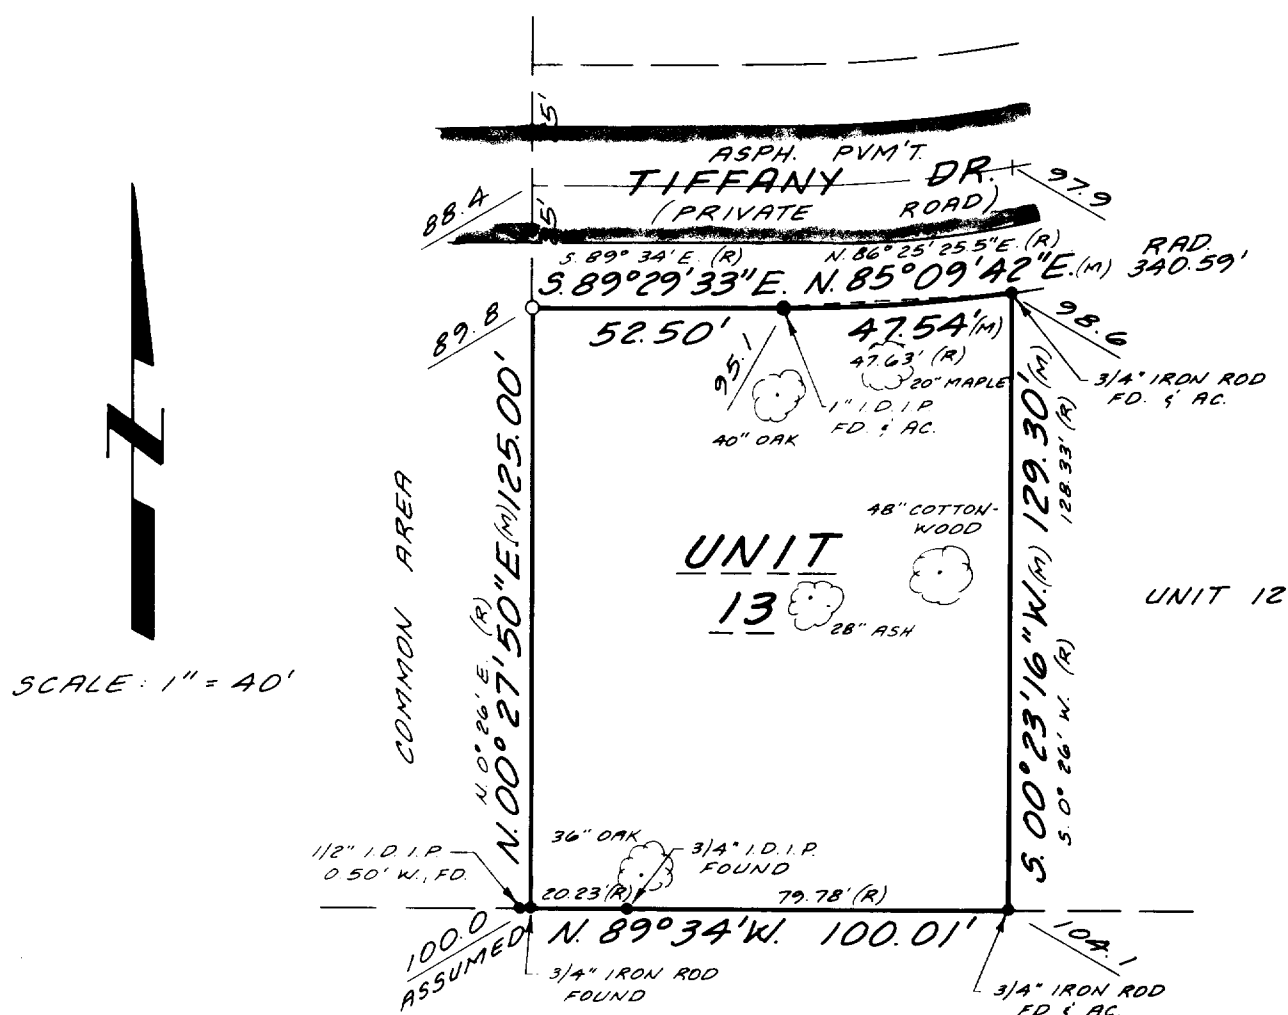

0 - 1" I.D. x 24" I.P. SET W/YELLOW PLASTIC.
PLUG STAMPED "R.L.S 1673" INSERTED IN
TOP OF PIPE

I.D. - INSIDE DIAMETER
I.P. - IRON PIPE
FD. - FOUND
AC. - ACCEPTED
(M) - MEASURED AS
(R) - RECORDED AS

7-725