


FARRIS, HANSEN & ASSOC. INC.

ENGINEERING, SURVEYING AND LAND PLANNING
715 W. WALWORTH ST. - P.O. BOX 487 - ELKHORN, WI 53121
OFFICE: 414/723-2098

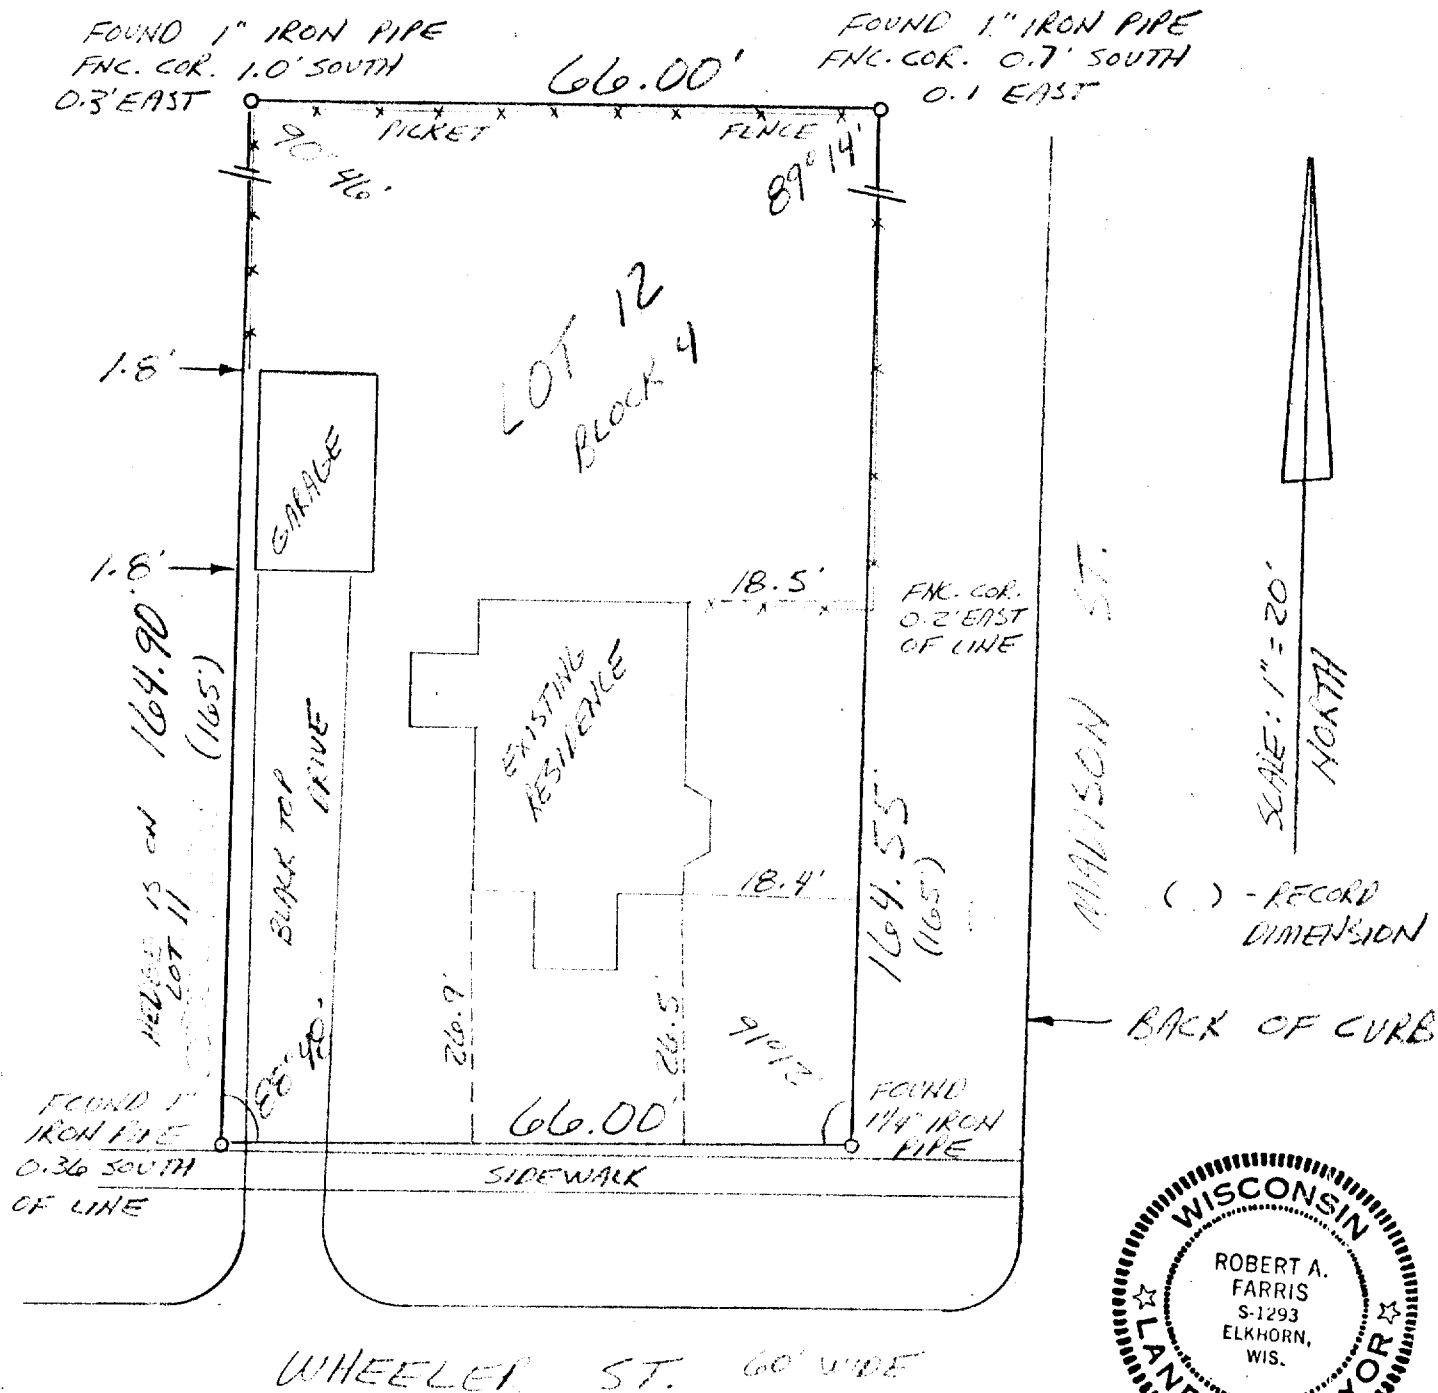

PLAT OF SURVEY

LOT 12, BLK 4, WHEELERS ADDITION TO
THE CITY OF LAKE GENEVA, WALWORTH CO., WIS.

I HEREBY CERTIFY THAT AT THE DIRECTION OF TAGGART
REALTY I HAVE SURVEIED THE PROPERTY DESCRIBED HERE ON
AND THAT THIS PLAT IS A CORRECT REPRESENTATION THEREOF.

ROBERT A. FARRIS

ROBERT A. FARRIS

DEC. 28, 1982

DRAWING NUMBER 2036