

PLAT OF SURVEY


THE SOUTH 70 FEET OF LOT 7, BLOCK 23, GENEVA LAKE CRAWFORD MANUFACTURING COMPANY'S ADDITION TO THE CITY OF LAKE GENEVA, WASHINGTON COUNTY, WISCONSIN.

FOR: KRIS AND PAULA OLSON

SCALE 1" = 20'

● = IRON PIPE STAKE FOUND

STREET ADDRESS: 533 WATER ST.

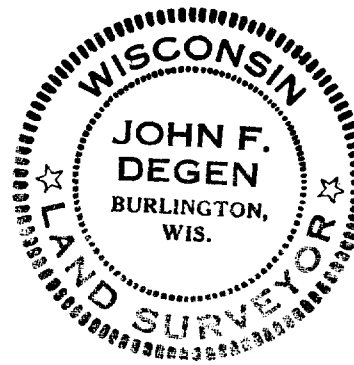

23RD
AUGUST 1983
John F. Degen

