


KOLB LAND CONSULTING, INC.
LAND SURVEYING • SUBDIVIDING • LAND PLANNING


LAKE GENEVA, WISCONSIN 53147

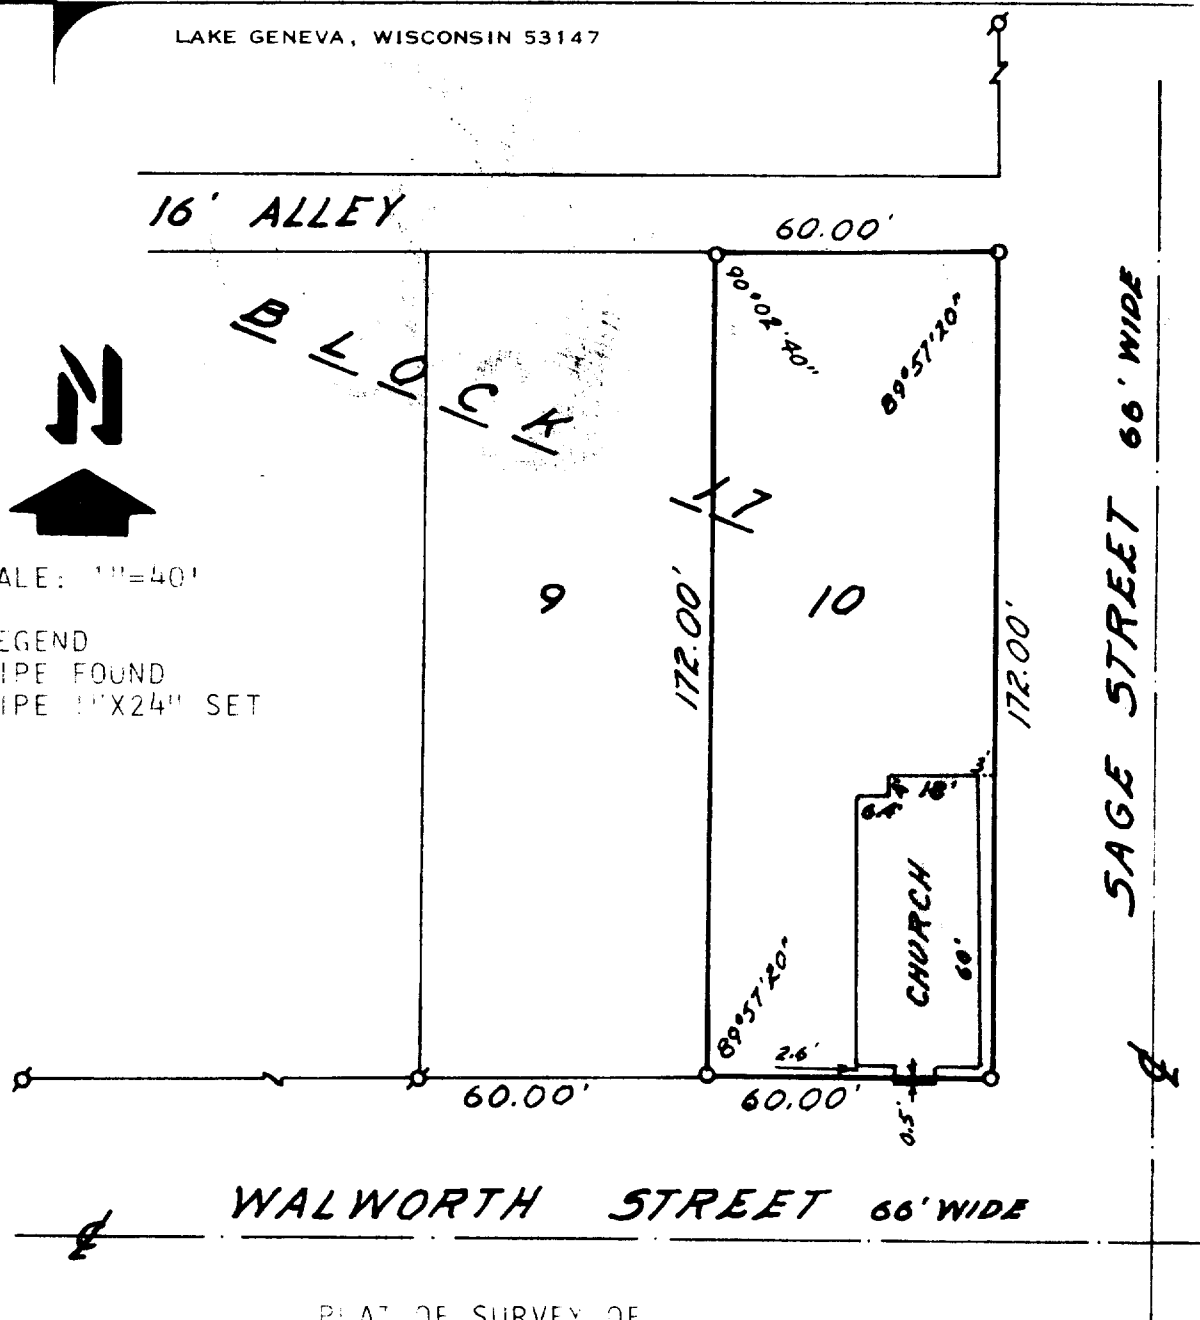

PLAT OF SURVEY OF

LOT 10, BLOCK 10, GENEVA LAKE CRAWFORD MANUFACTURING
COMPANY ADDITION TO THE CITY OF LAKE GENEVA, LOCATED IN
THE SOUTHEAST 1/4 OF SECTION 25, T 2 N, R 17 E, CITY OF
LAKE GENEVA, WALWORTH COUNTY, WISCONSIN.

ORDERED BY: STANLEY E. ENGSTROM
FOR: LAKE GENEVA BIBLE CHAPEL
601 WALWORTH STREET
LAKE GENEVA, WI. 53147

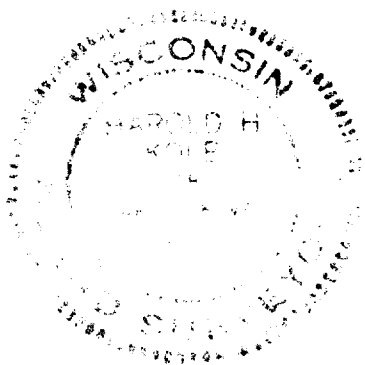

I, HAROLD H. KOLB DO HEREBY CERTIFY
THAT I HAVE SURVEYED THE PROPERTY
HEREON DESCRIBED ACCORDING TO THE
OFFICIAL RECORDS, AND THAT THE PLAT
HEREON IS A CORRECT REPRESENTATION
OF THE LOT LINES AND THE PRINCIPAL
LINES OF THE BUILDINGS THEREON TO
THE BEST OF MY KNOWLEDGE AND BELIEF.

Harold H. Kolb

WISCONSIN REGISTERED LAND SURVEYOR, S-187
DATE FEBRUARY 14, 1983