



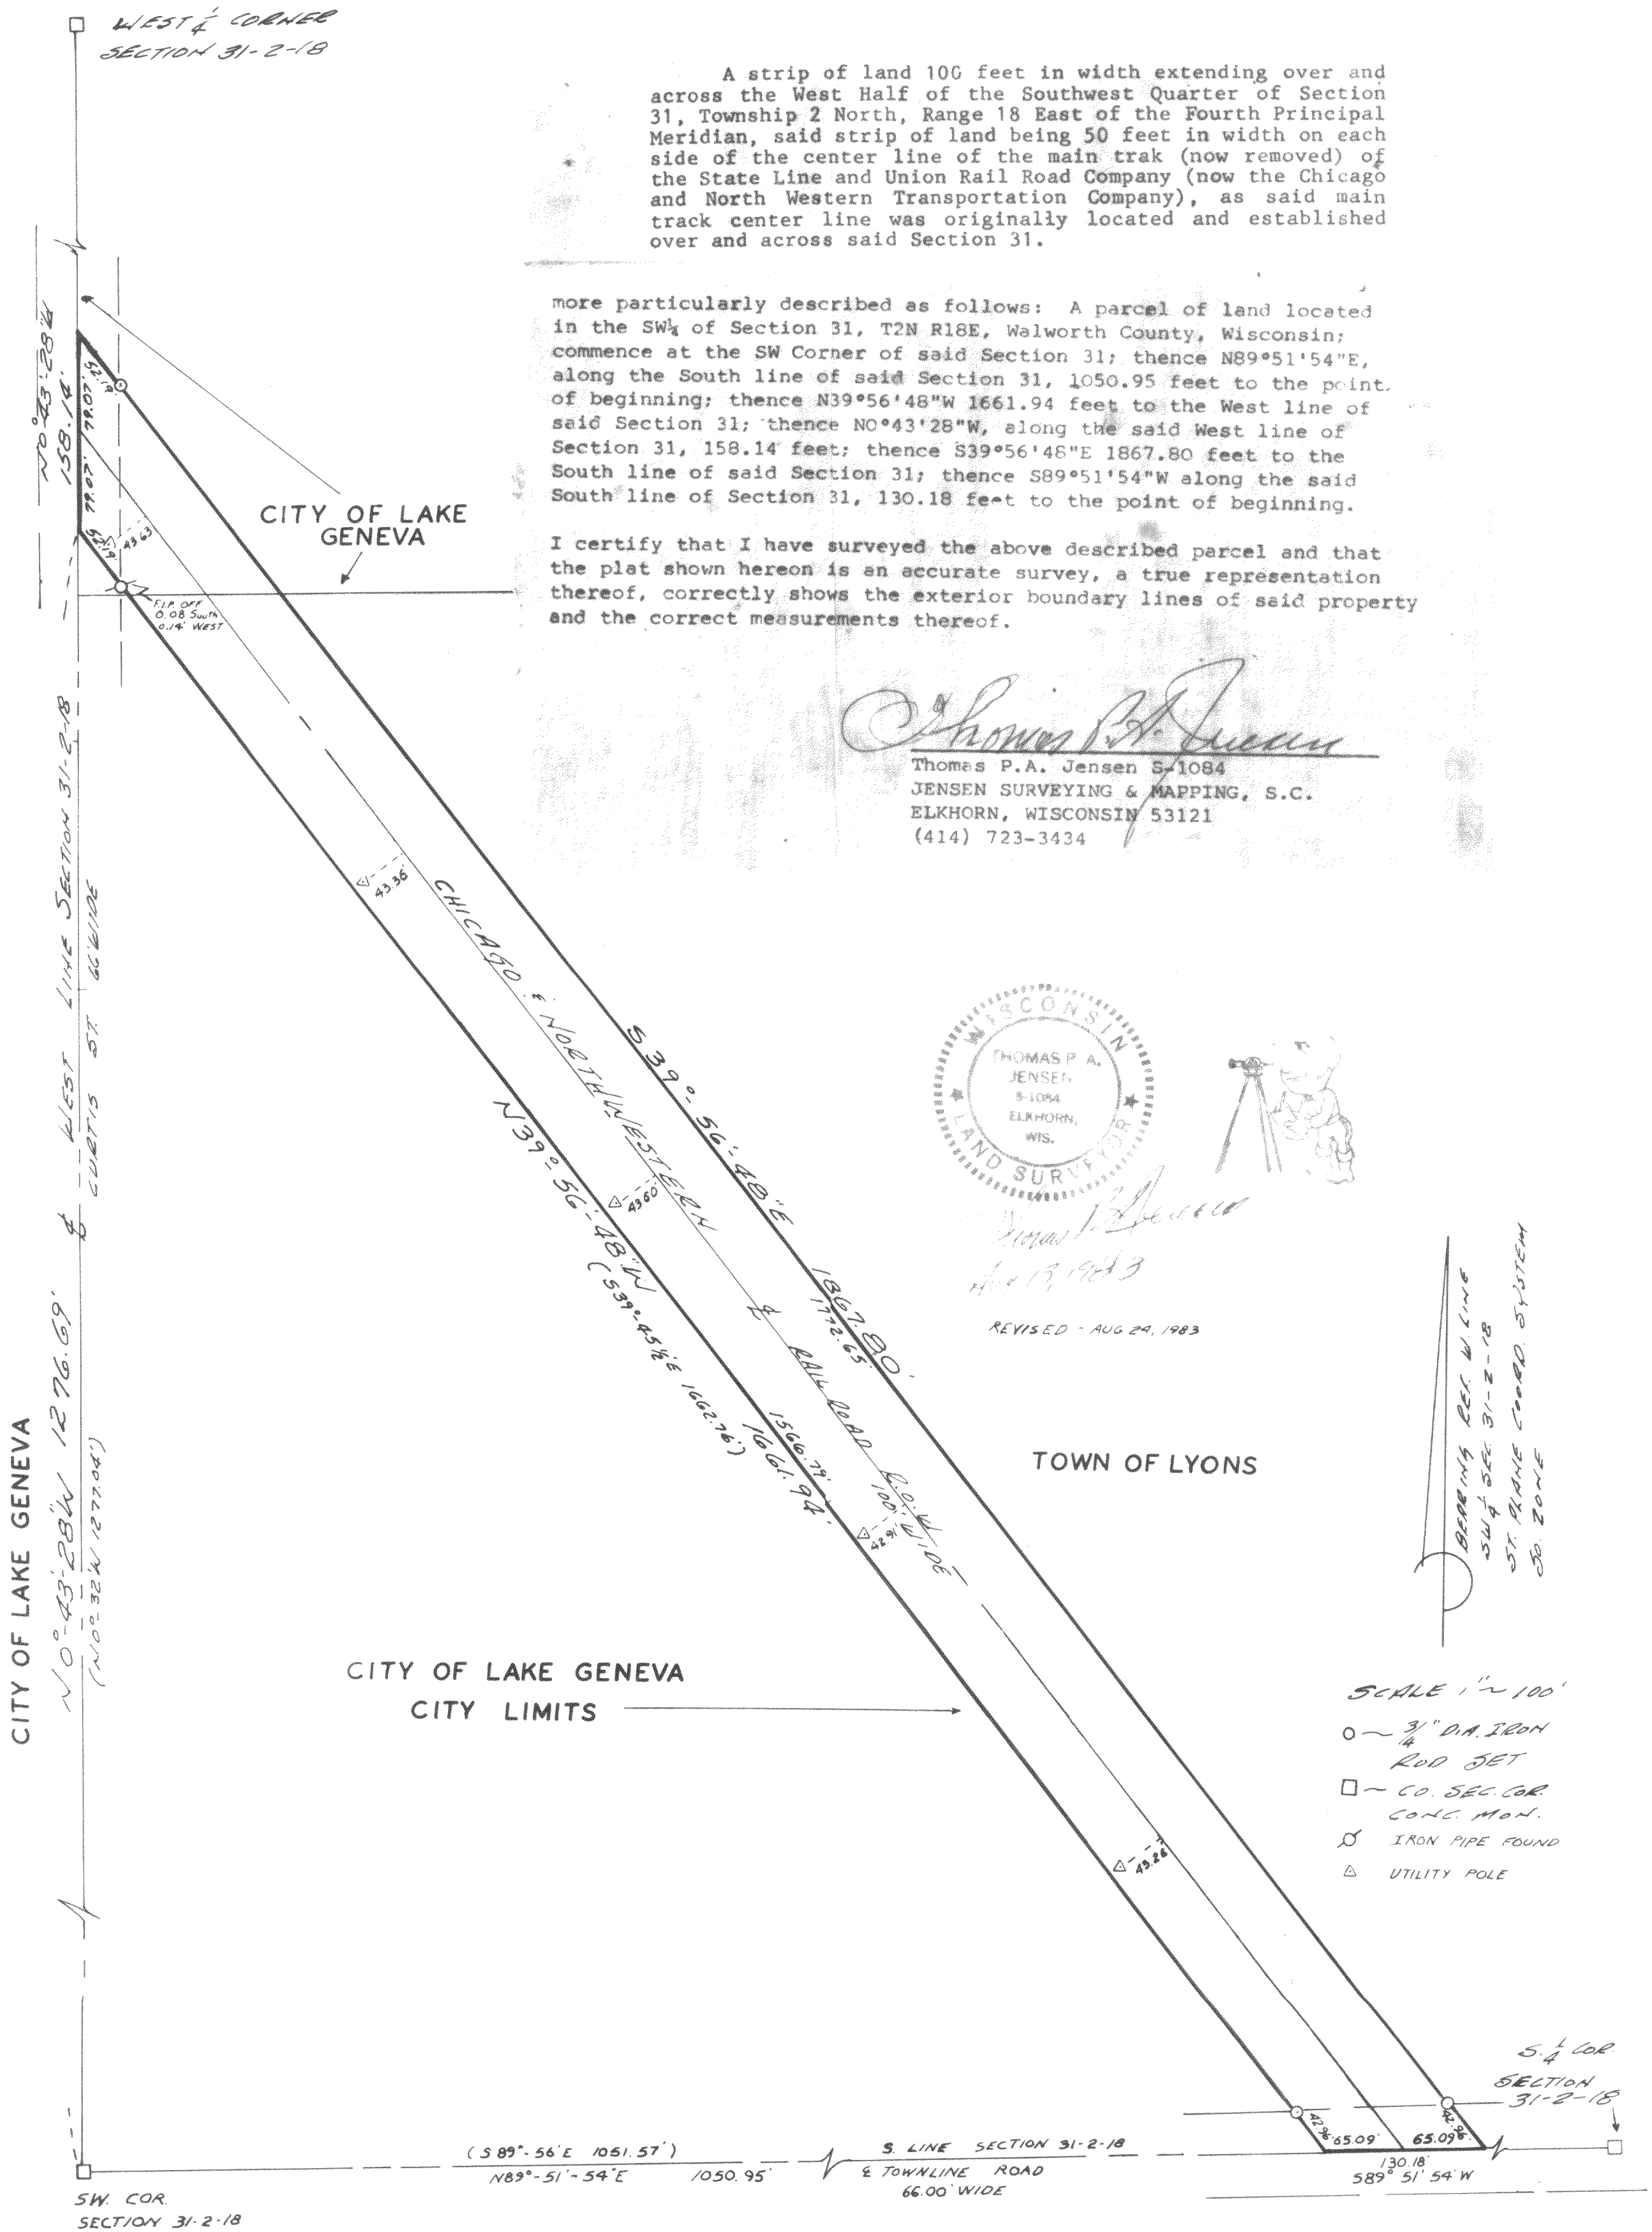


A strip of land 100 feet in width extending over and across the West Half of the Southwest Quarter of Section 31, Township 2 North, Range 18 East of the Fourth Principal Meridian, said strip of land being 50 feet in width on each side of the center line of the main trak (now removed) of the State Line and Union Rail Road Company (now the Chicago and North Western Transportation Company), as said main track center line was originally located and established over and across said Section 31.

more particularly described as follows: A parcel of land located in the SW 1/4 of Section 31, T2N R18E, Walworth County, Wisconsin; commence at the SW Corner of said Section 31; thence N89°51'54"E, along the South line of said Section 31, 1050.95 feet to the point of beginning; thence N39°56'48"W 1661.94 feet to the West line of said Section 31; thence N0°43'28"W, along the said West line of Section 31, 158.14 feet; thence S39°56'48"E 1867.80 feet to the South line of said Section 31; thence S89°51'54"W along the said South line of Section 31, 130.18 feet to the point of beginning.

I certify that I have surveyed the above described parcel and that the plat shown hereon is an accurate survey, a true representation thereof, correctly shows the exterior boundary lines of said property and the correct measurements thereof.

Thomas P.A. Jensen
Thomas P.A. Jensen S-1084
JENSEN SURVEYING & MAPPING, S.C.
ELKHORN, WISCONSIN 53121
(414) 723-3434

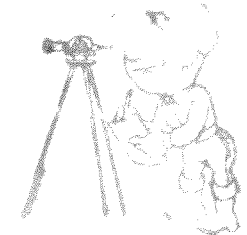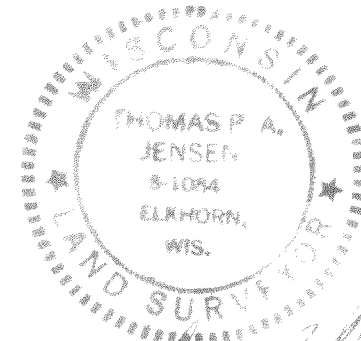

REVISED - AUG 29, 1983

SCALE 1" = 100'

- ~ 3/4" DIA. IRON ROD SET
- ~ CO. SEC. COR CONG. MON.
- ⊗ IRON PIPE FOUND
- △ UTILITY POLE

5.4 COR
SECTION 31-2-18
130.18'
589° 51' 54" W

TOWN OF BLOOMFIELD