


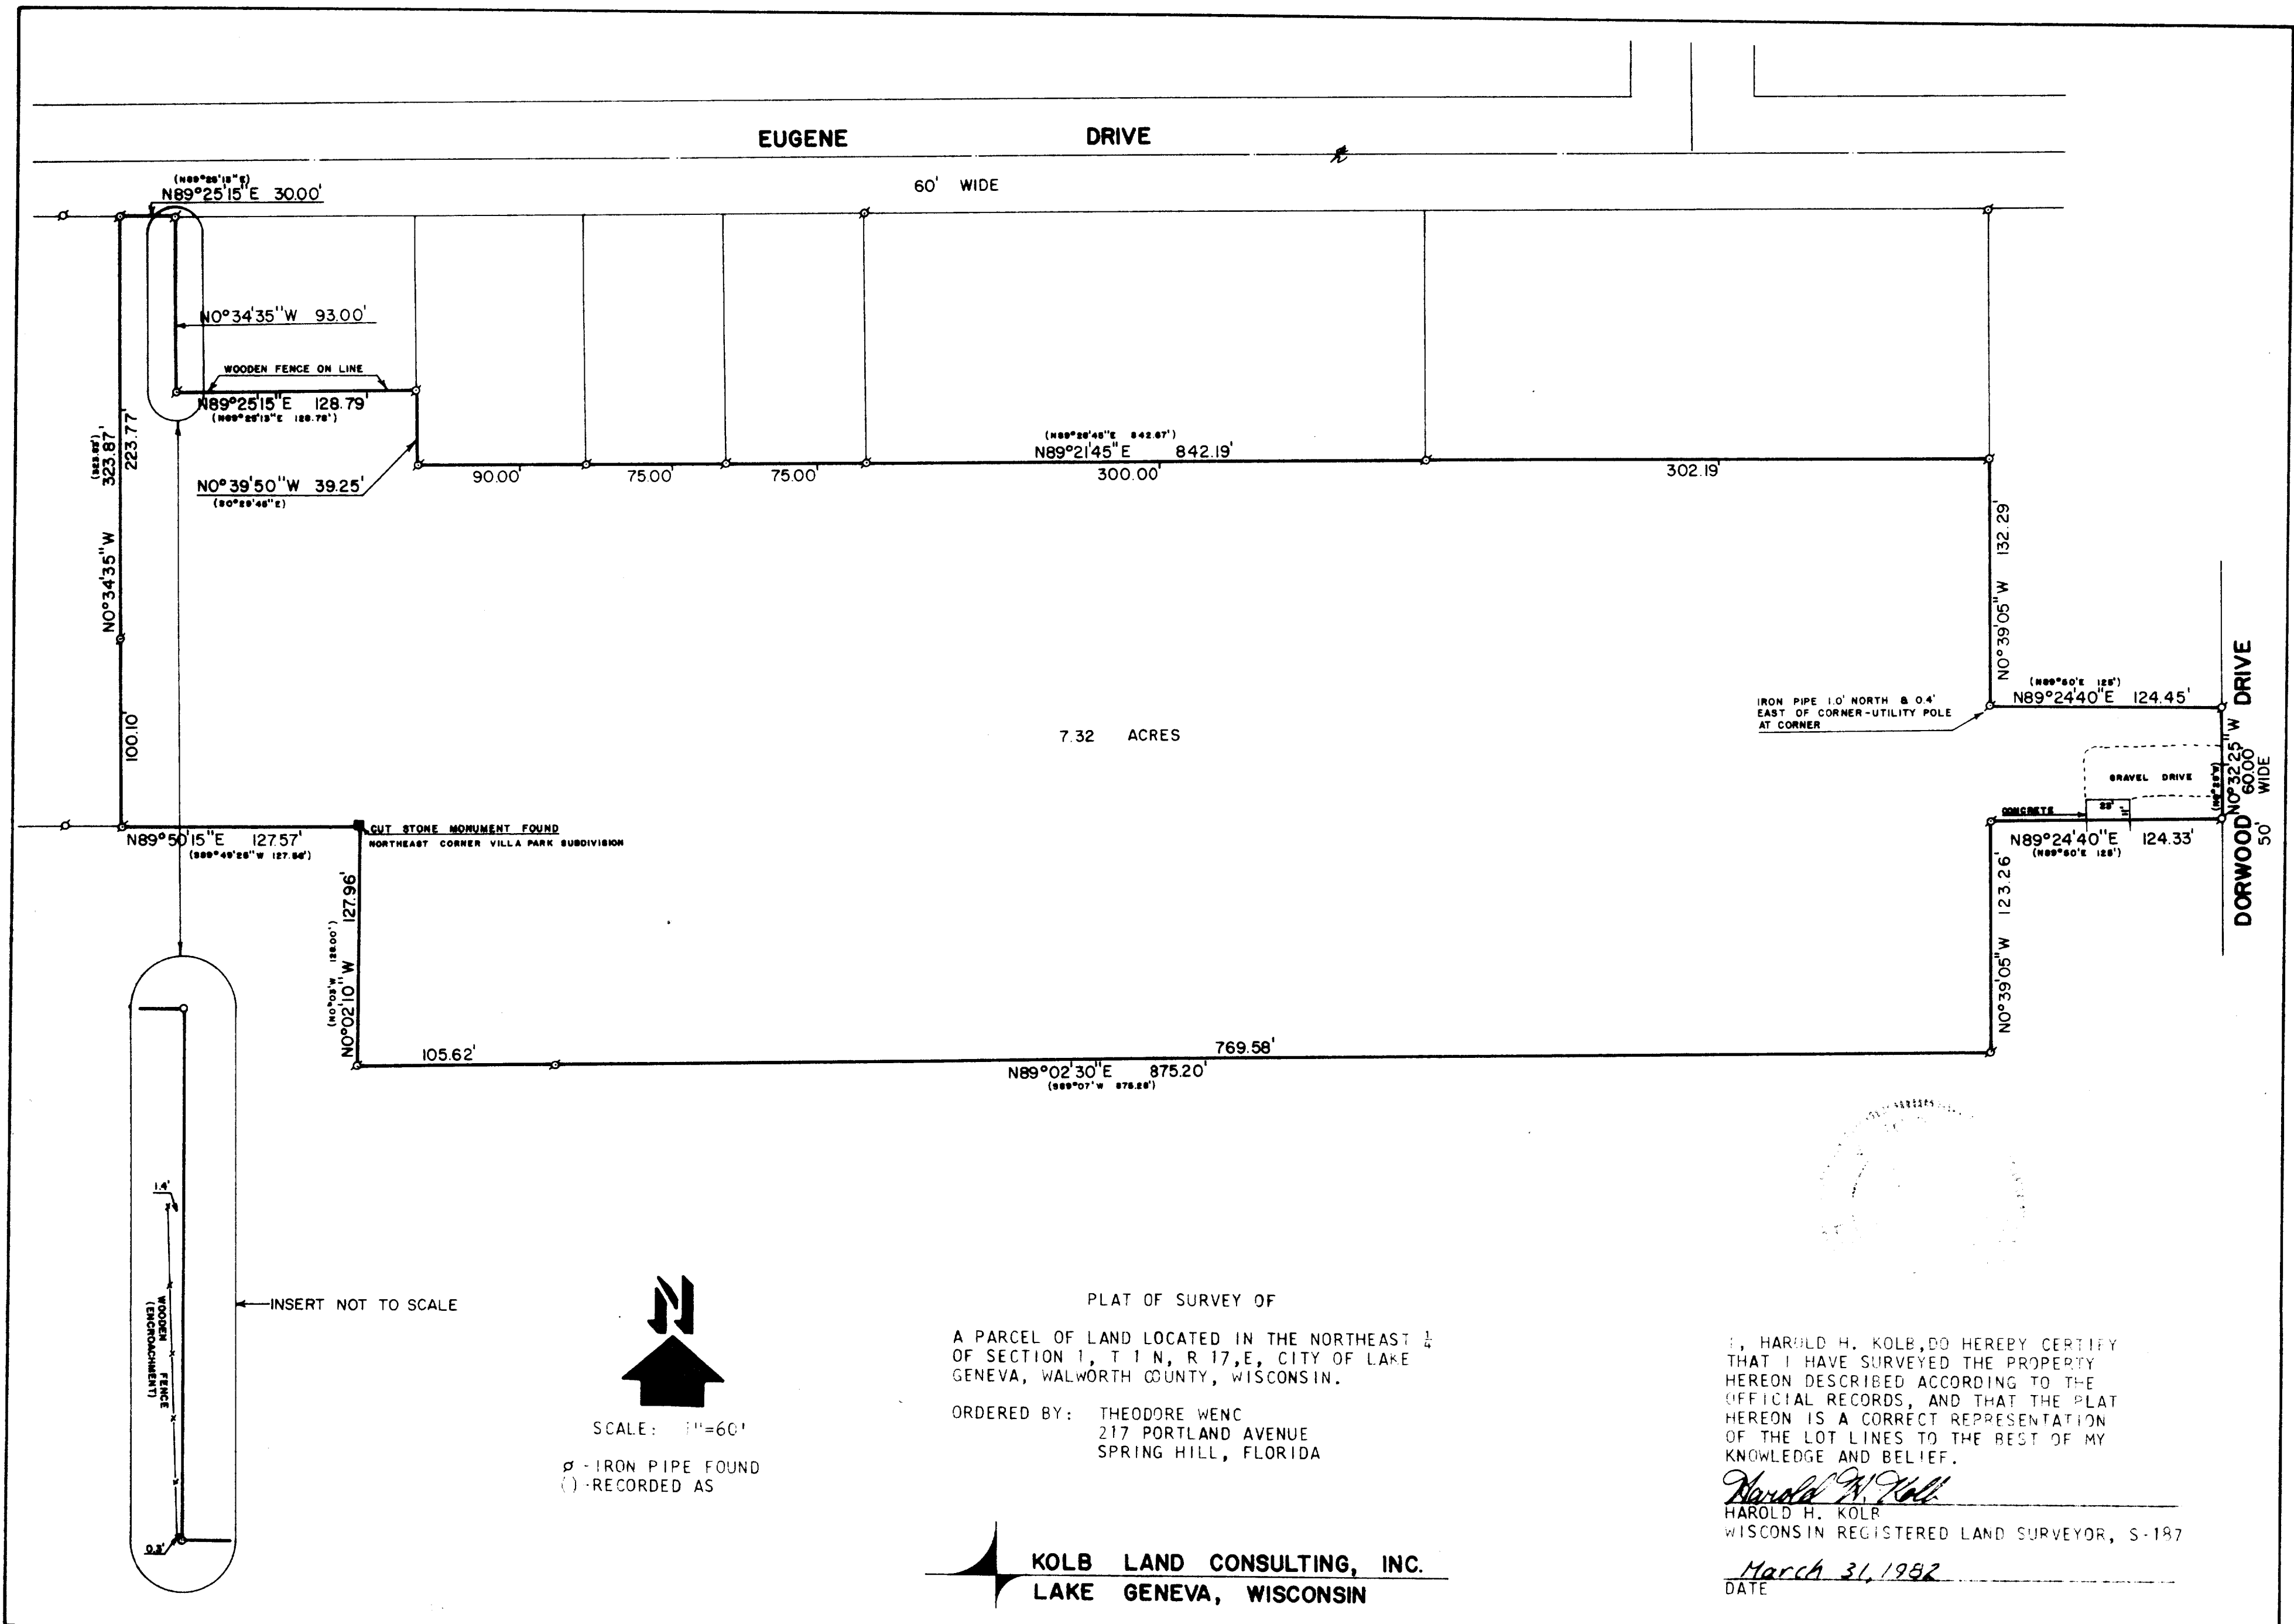

SCALE: 1"=60'
σ - IRON PIPE FOUND
() - RECORDED AS

PLAT OF SURVEY OF
A PARCEL OF LAND LOCATED IN THE NORTHEAST 1/4
OF SECTION 1, T 1 N, R 17, E, CITY OF LAKE
GENEVA, WALWORTH COUNTY, WISCONSIN.
ORDERED BY: THEODORE WENC
217 PORTLAND AVENUE
SPRING HILL, FLORIDA
KOLB LAND CONSULTING, INC.
LAKE GENEVA, WISCONSIN

I, HAROLD H. KOLB, DO HEREBY CERTIFY
THAT I HAVE SURVEYED THE PROPERTY
HEREON DESCRIBED ACCORDING TO THE
OFFICIAL RECORDS, AND THAT THE PLAT
HEREON IS A CORRECT REPRESENTATION
OF THE LOT LINES TO THE BEST OF MY
KNOWLEDGE AND BELIEF.
Harold H. Kolb
HAROLD H. KOLB
WISCONSIN REGISTERED LAND SURVEYOR, S-187
March 31, 1982
DATE

YDP-121

7-745-K