

CP

FOR: LAKES AREA BUILDERS


SCALE 1" = 20'

x = CROSS CUT IN CONCRETE

O = IRON PIPE STAKE FOUND.

PROPOSED BUILDING STAGED ON SITE.

⊗ = MASONRY NAIL SET

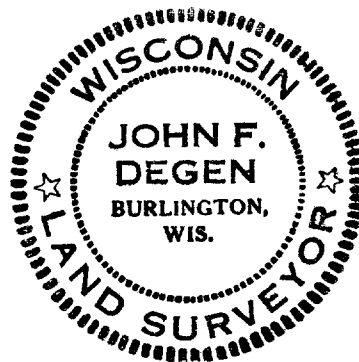


N

... 11th day

JANUARY 24

John F. Deegan

REVISED 3-19-84 TO
SHOW FOUNDATION LOCATION.

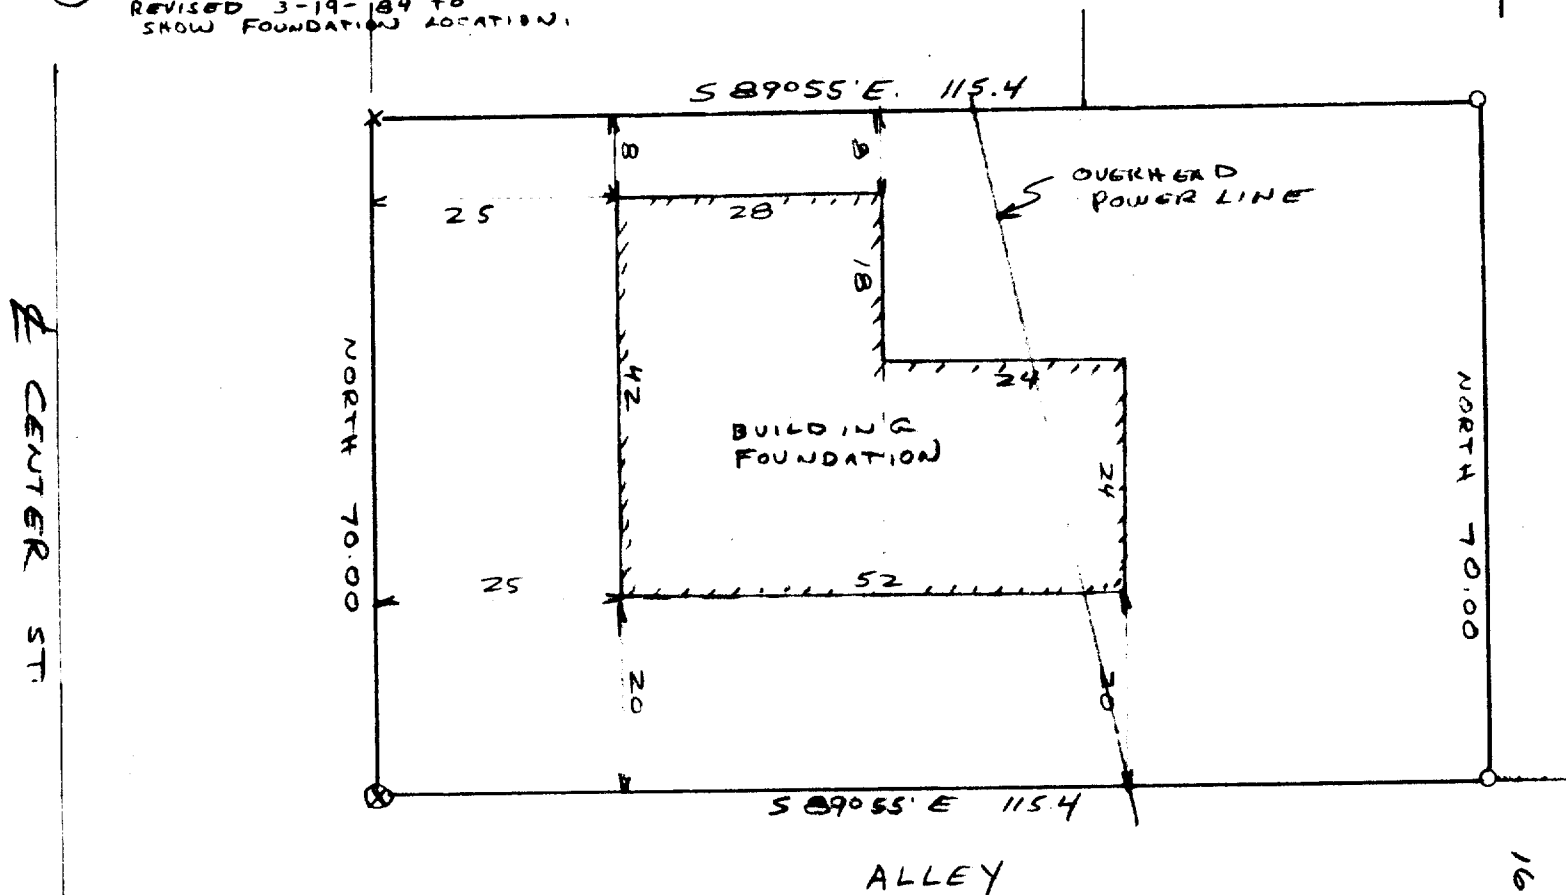

PLAT OF SURVEY

OF

PARCEL "C" OF CERTIFIED SURVEY MAP NO. 641 FOR THE DIVISION OF LOTS 4 & 5, BLOCK 16 OF GENEVA LAKE CRAWFORD MANUFACTURING CO. ADDITION, LOCATED IN THE CITY OF LAKE GENEVA, WALWORTH COUNTY, WISCONSIN.

FOR: LAKES AREA BUILDERS


SCALE 1" = 20'

x = CROSS CUT IN CONCRETE

o = IRON PIPE STAKE FOUND.

PROPOSED BUILDING STAKED ON SITE.

⊗ = MASONRY WALL SET

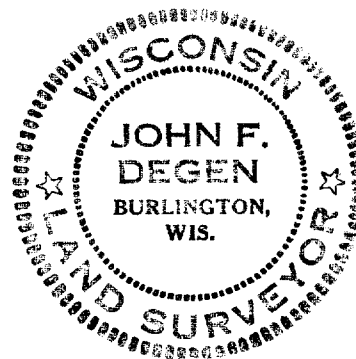

11th
JANUARY 84
John F. Degen

2 CENTER ST.

