


WALWORTH COUNTY
SURVEYING & MAPPING
LAKE GENEVA, WISCONSIN

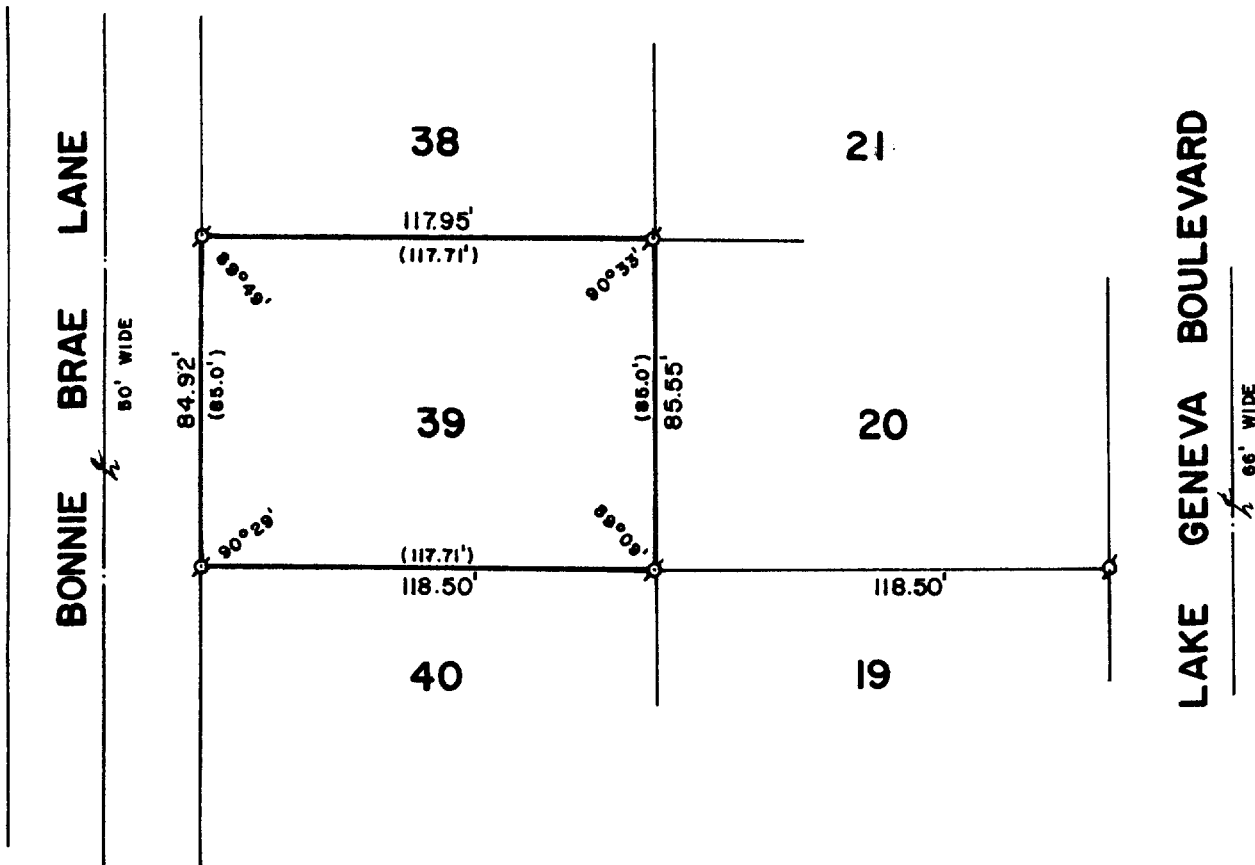


PLAT OF SURVEY OF

LOT 39 OF H. E. WELLS ADDITION TO THE CITY
OF LAKE GENEVA, T 1 N, R 17 E, WALWORTH
COUNTY, WISCONSIN.

ORDERED BY: STURGE TAGGART AGENCY
736 MAIN STREET
LAKE GENEVA, WISCONSIN 53147

NOTE: THIS PLAT OF SURVEY REPRESENTS ONLY THE
EXISTING MONUMENTATION AS FOUND ON LOT
39 OF H. E. WELLS ADDITION.

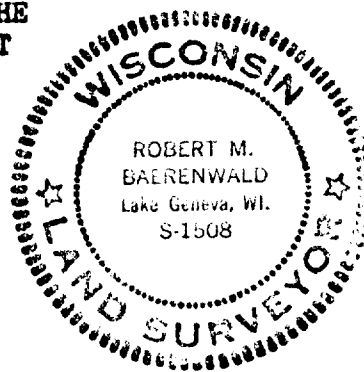

SCALE: 1"=50'

σ-IRON PIPE FOUND
()-RECORDED AS

I, ROBERT M. BAERENWALD, DO HEREBY CERTIFY THAT I
HAVE SURVEYED THE PROPERTY HEREON DESCRIBED ACCORDING
TO THE OFFICIAL RECORDS AND THAT THE PLAT HEREON IS A
CORRECT REPRESENTATION OF THE PROPERTY LINES TO THE
BEST OF MY KNOWLEDGE AND BELIEF.

Robert M. Baerenwald 3/4/84
ROBERT M. BAERENWALD
WISCONSIN REGISTERED LAND SURVEYOR, S-1508

JOB NO. 0028

WV E-00187

7-754-RB