


WALWORTH COUNTY
SURVEYING & MAPPING
LAKE GENEVA, WISCONSIN

DODGE STREET


80' WIDE

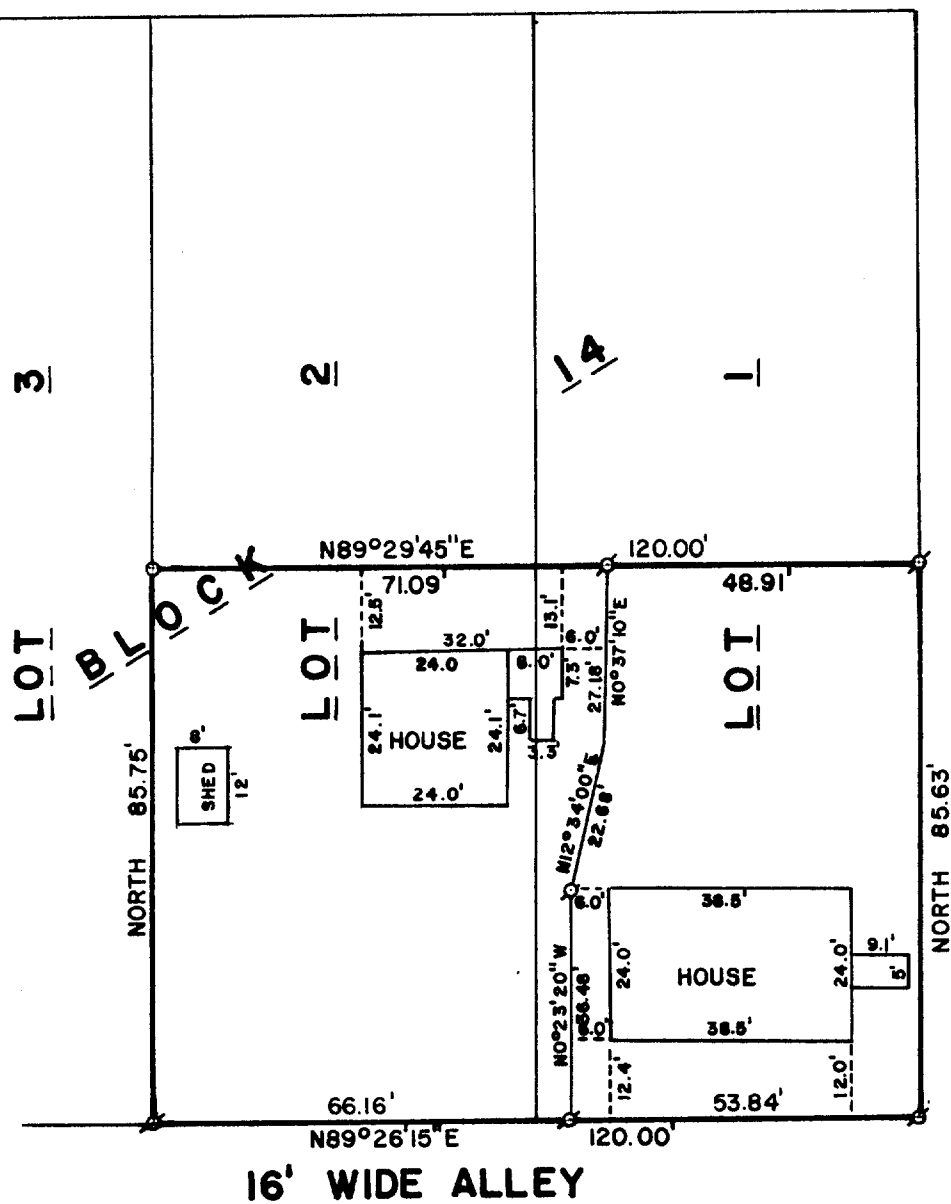

PLAT OF SURVEY OF

THE SOUTH 1/2 OF LOTS 1 AND 2, BLOCK 14,
ORIGINAL PLAT, CITY OF LAKE GENEVA, WALWORTH
COUNTY, WISCONSIN.

ORDERED BY: STURG TAGGART AGENCY
736 MAIN STREET
LAKE GENEVA, WISCONSIN 53147

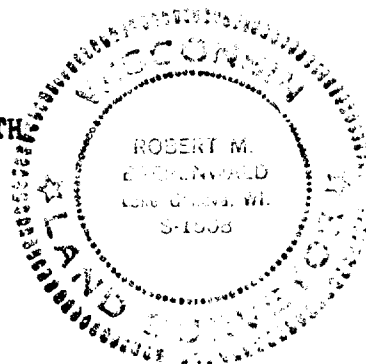

SCALE: 1"=30'

o - IRON PIPE FOUND
o - IRON PIPE PLACED

I, ROBERT M. BAERENWALD, DO HEREBY CERTIFY
THAT I HAVE SURVEYED THE PROPERTY HEREON
DESCRIBED ACCORDING TO THE OFFICIAL RECORDS
AND THAT THE PLAT HEREON IS A CORRECT REP-
RESENTATION OF THE PROPERTY LINES TO THE BEST
OF MY KNOWLEDGE AND BELIEF.

Robert M. Baerenwald
ROBERT M. BAERENWALD
WISCONSIN REGISTERED LAND SURVEYOR, S-1508

February 8, 1984
DATE

JOB NO. 0022

CP-120
CP-120 B

7-758-RB