


N

SCALE 1"=20'

○=IRON PIPE

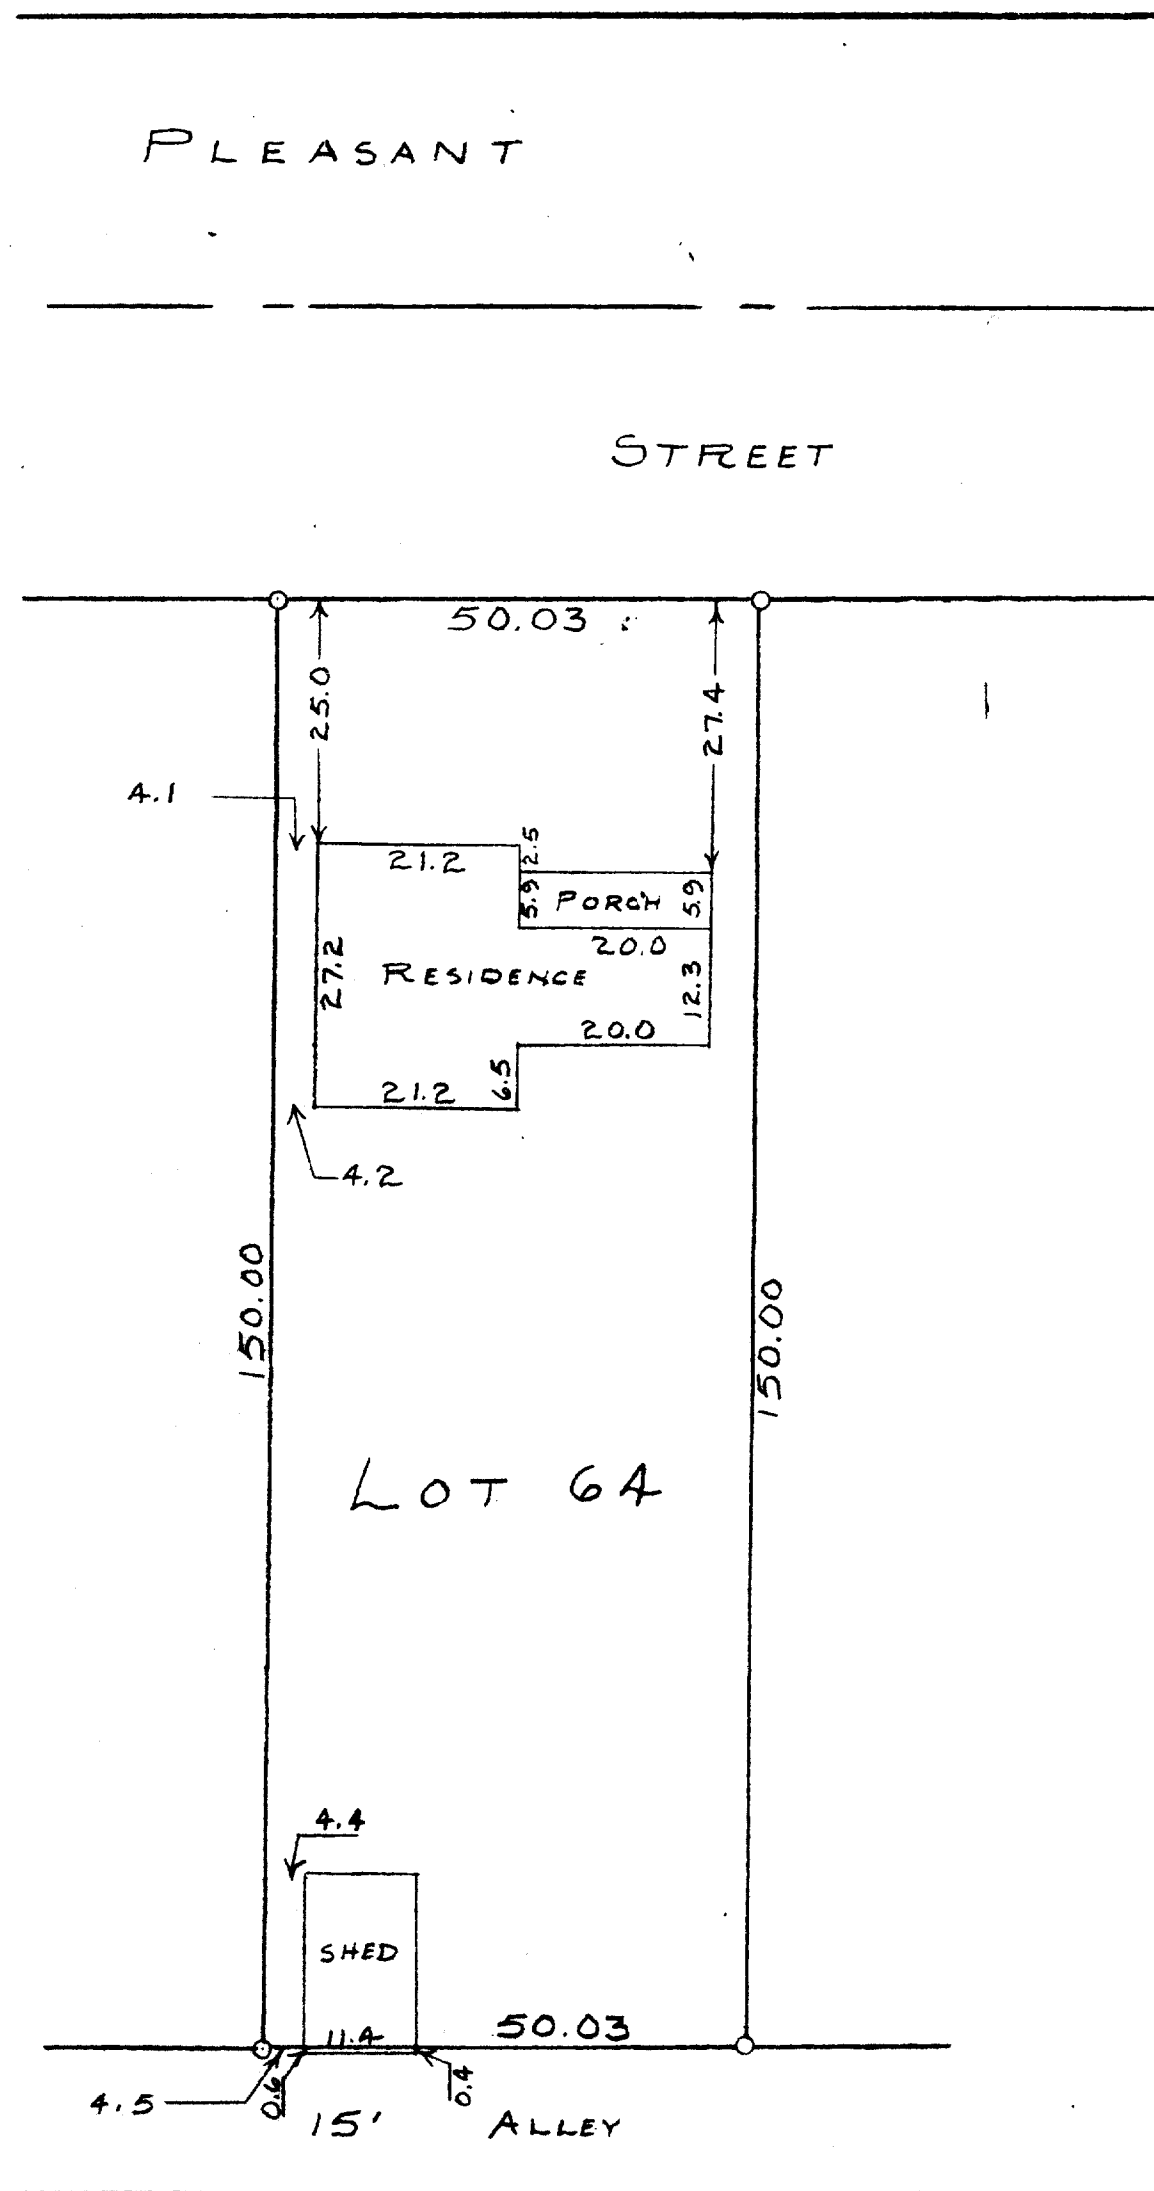

STATE OF WISCONSIN)
 WALWORTH COUNTY) ss

I, GEORGE T. DUNHAM, DO HEREBY CERTIFY THAT I HAVE SURVEYED
 THE PROPERTY DESCRIBED AS FOLLOWS:

LOT 64, COLUMBIAN SUBDIVISION, LOCATED IN THE CITY
 OF LAKE GENEVA, WALWORTH COUNTY, WISCONSIN.
 AND THAT THE PLAT SHOWN ABOVE IS A CORRECT REPRESENTATION OF
 THE PROPERTY LINES AND OF THE IMPROVEMENTS LOCATED THEREON.
 NOV. 12, 1959

George T. Dunham
 GEORGE T. DUNHAM, SURVEYOR
 DELAVAN, WISCONSIN 7-76