


KOLB LAND CONSULTING, INC.
LAND SURVEYING • SUBDIVIDING • LAND PLANNING



LAKE GENEVA, WISCONSIN 53147

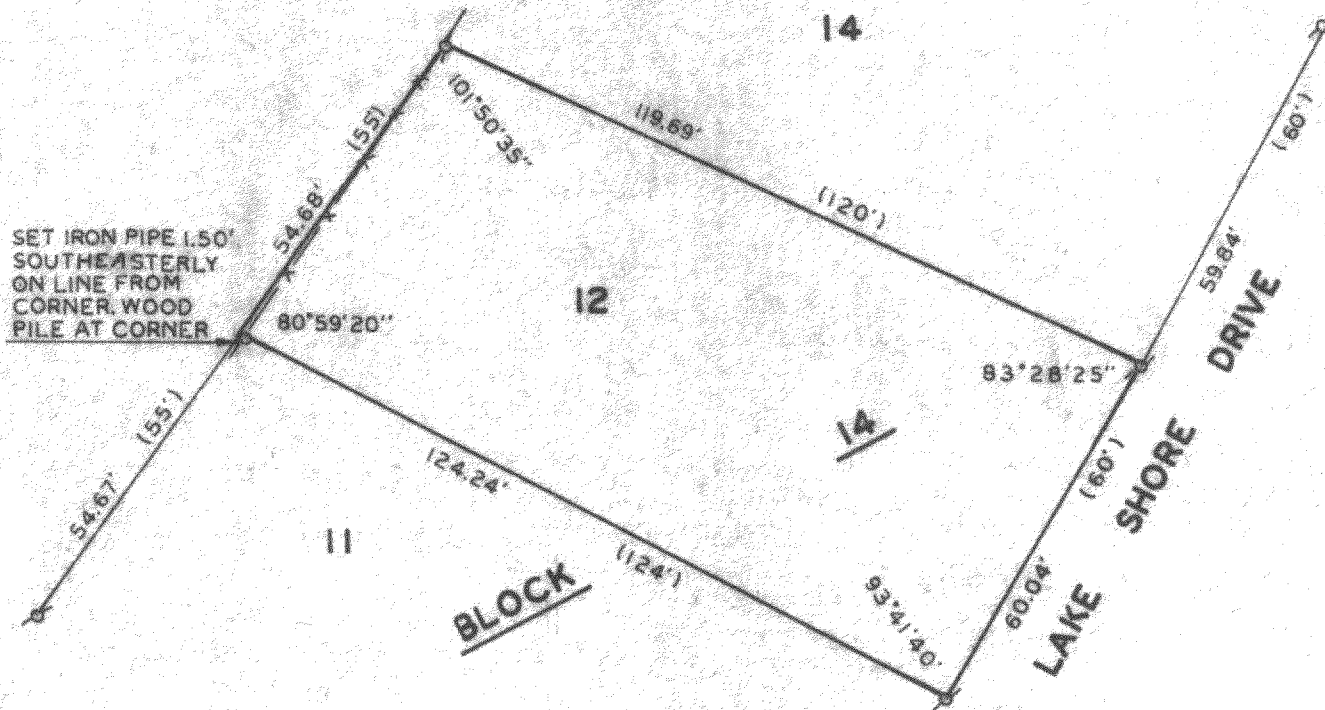

PLAT OF SURVEY OF

LOT 12, BLOCK 14, LAKE GENEVA MANOR, CITY OF
LAKE GENEVA, WALWORTH COUNTY, WISCONSIN

OWNER: CHARLES BOWMAN
1625 LAKE SHORE DRIVE
LAKE GENEVA, WI 53147

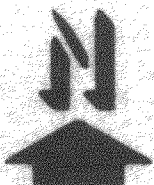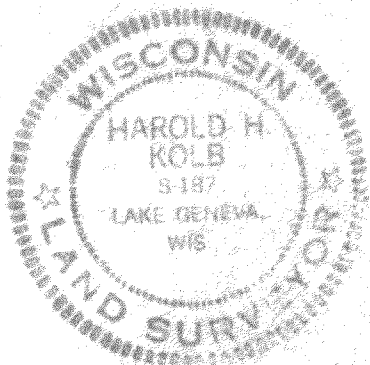

SCALE - 1"=50'

LEGEND

- ✕ IRON PIPE FOUND
- IRON PIPE SET
- () RECORDED AS
- x— FENCE

I, HAROLD H. KOLB, DO HEREBY CERTIFY
THAT I HAVE SURVEYED THE PROPERTY
HEREON DESCRIBED ACCORDING TO THE
OFFICIAL RECORDS, AND THAT THE PLAT
HEREON IS A CORRECT REPRESENTATION
OF THE LOT LINES TO THE BEST OF MY
KNOWLEDGE AND BELIEF.

Harold H. Kolb

HAROLD H. KOLB
WISCONSIN REGISTERED LAND SURVEYOR, S-187
DATE MARCH 1, 1985

ZLM-22

7-762-K

LG-LM-22