


KOLB LAND CONSULTING, INC.
LAND SURVEYING • SUBDIVIDING • LAND PLANNING

LAKE GENEVA, WISCONSIN 53147

WHITEWATER, WISCONSIN 53190

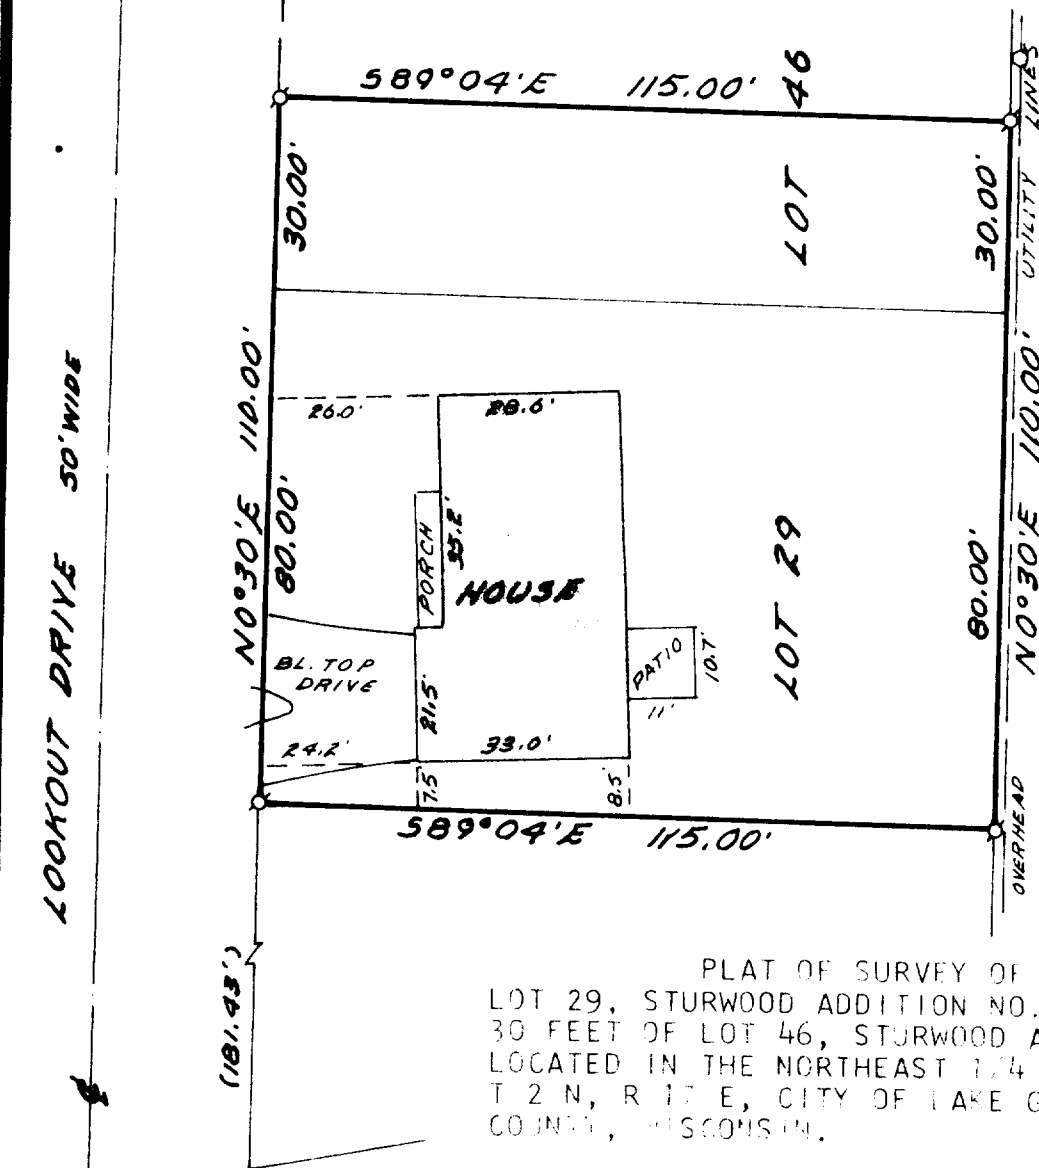

PLAT OF SURVEY OF
LOT 29, STURWOOD ADDITION NO. 1, AND THE SOUTH
30 FEET OF LOT 46, STURWOOD ADDITION NO. 2,
LOCATED IN THE NORTHEAST 1/4 OF SECTION 35,
T 2 N, R 17 E, CITY OF LAKE GENEVA, WA. WORTH
COUNTY, WISCONSIN.

ORDERED BY: LAKE GENEVA REALTY
737 MAIN STREET
LAKE GENEVA, WI. 53147

NOTE: BEARING ARE ASSUMED AS SHOWN ON THE
RECORDED PLATS OF STURWOOD ADDITIONS.

I HEREBY CERTIFY THAT I HAVE SURVEYED THE
ABOVE DESCRIBED PROPERTY AND THAT THE ABOVE
MAP IS A TRUE REPRESENTATION THEREOF AND
SHOWS THE SIZE AND LOCATION OF THE PROPERTY,
ITS EXTERIOR BOUNDARIES, THE LOCATION OF ALL
VISIBLE STRUCTURES AND DIMENSIONS OF ALL
PRINCIPAL BUILDING THEREON, BOUNDARY LINES,
APPARENT EASEMENTS, ROADWAYS AND VISIBLE
ENCROACHMENTS, IF ANY.

THIS SURVEY IS MADE FOR THE USE OF THE
PRESENT OWNERS OF THE PROPERTY, AND ALSO
THOSE WHO PURCHASE, MORTGAGE, OR GUARANTEE
THE TITLE THERETO WITHIN ONE (1) YEAR FROM
THE DATE HEREOF.

Harold H. Kolb

HAROLD H. KOLB
WISCONSIN REGISTERED LAND SURVEYOR, S- 87
DATE JULY 23, 1984

ST-28 + ST2-2A

7-765-K