


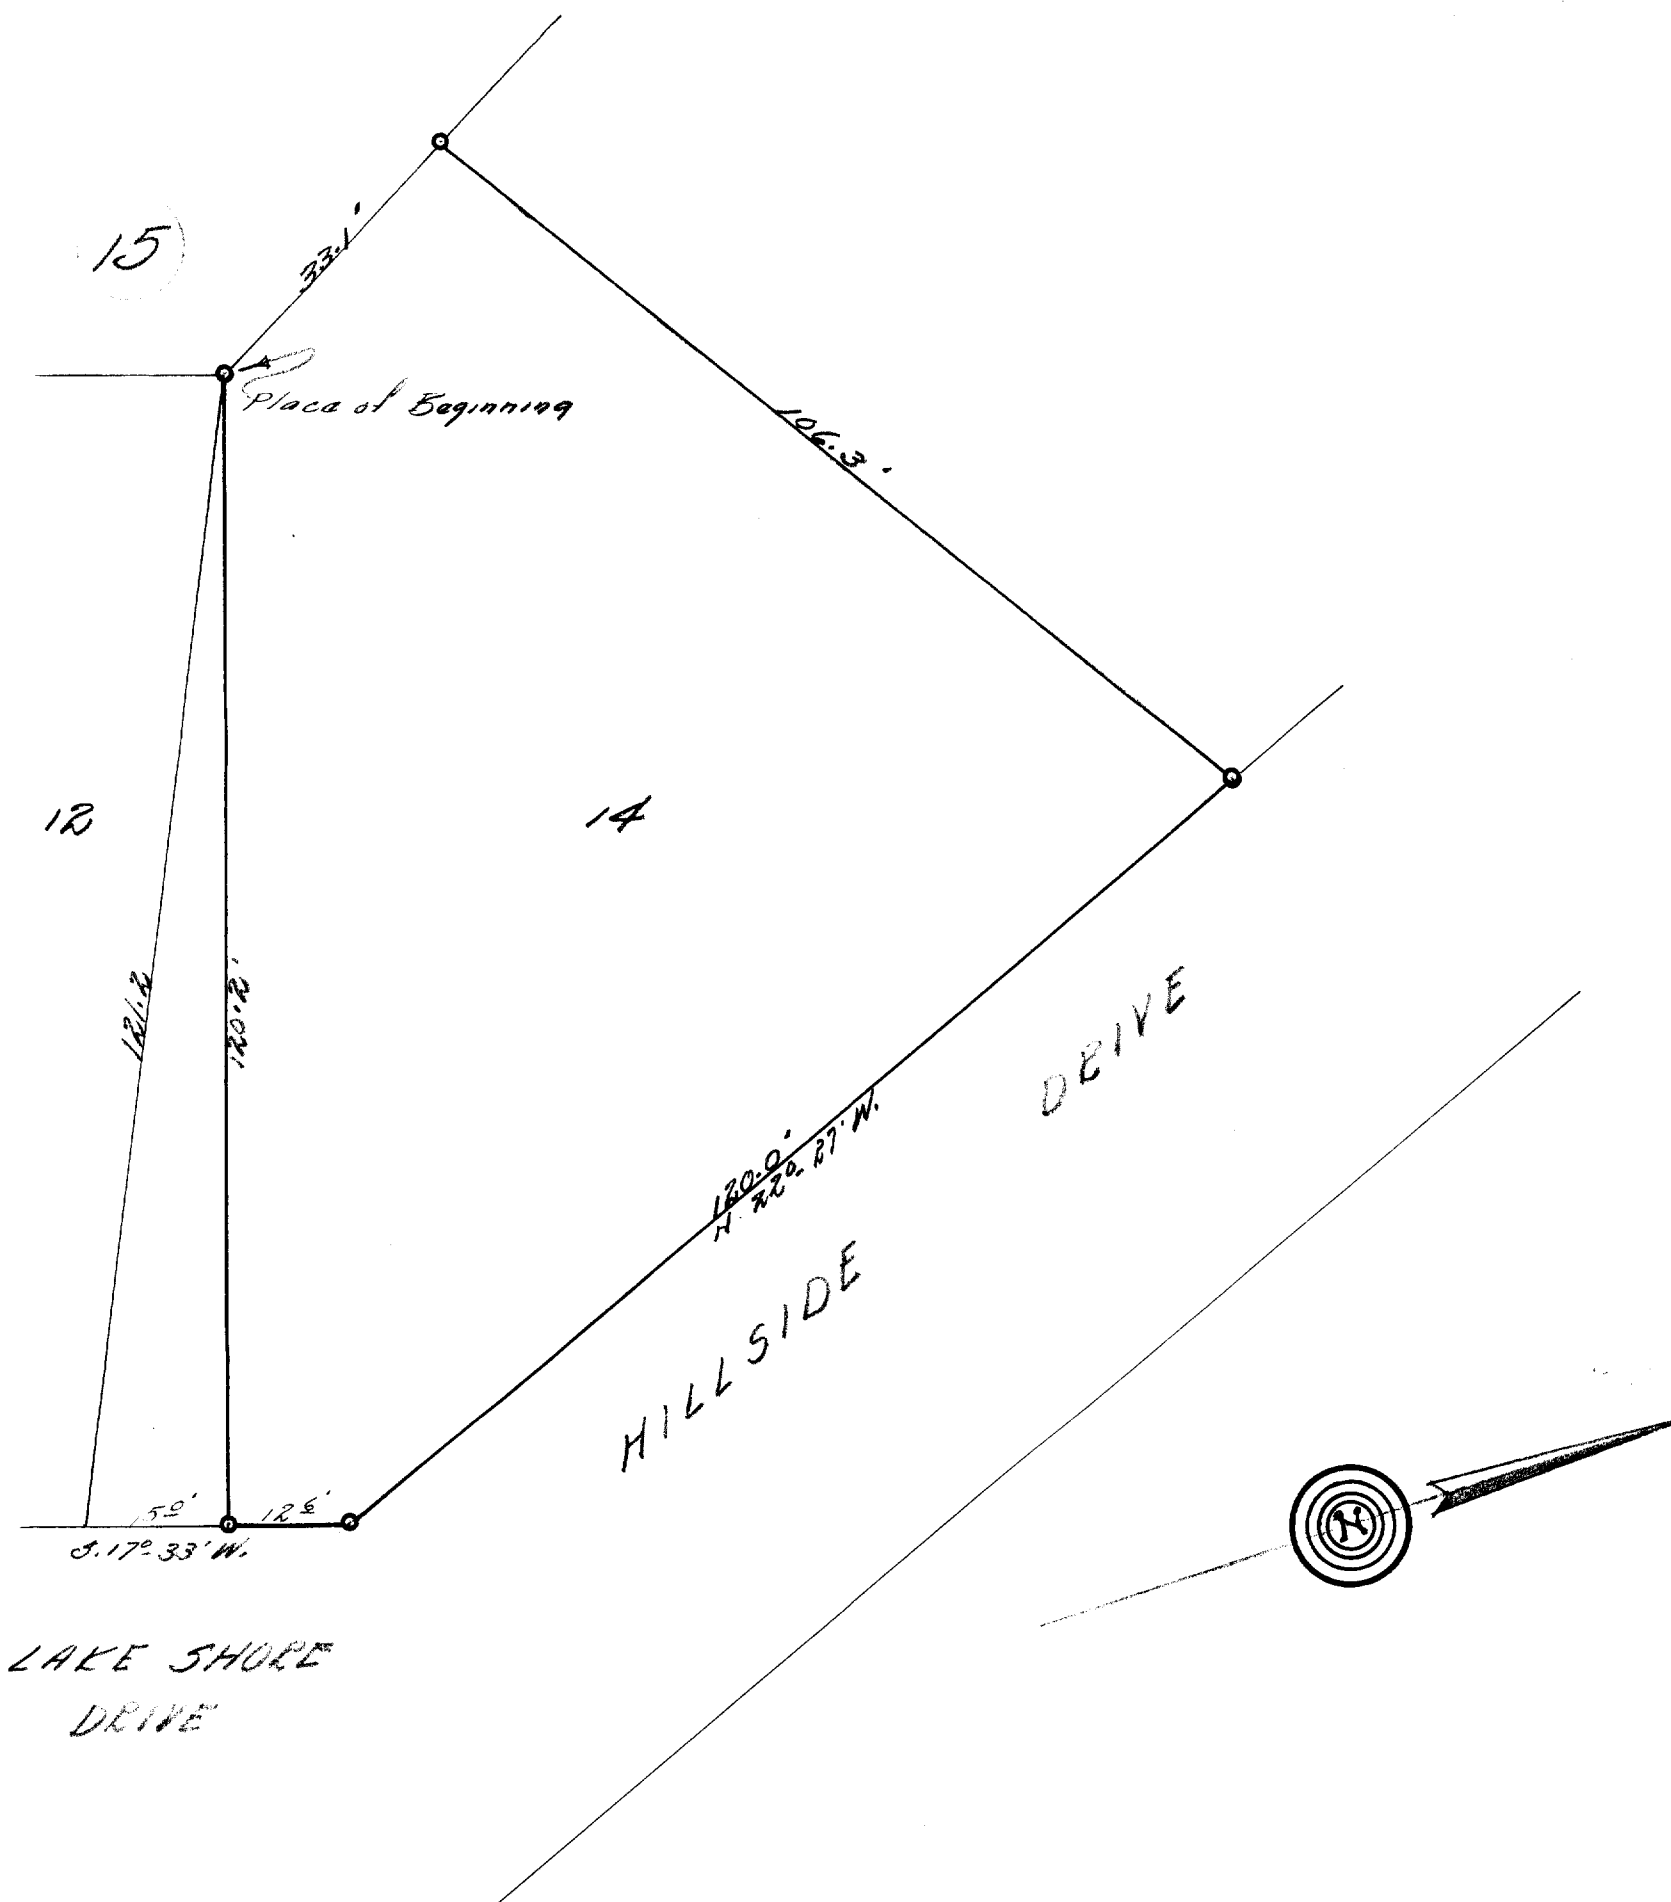

DESCRIPTION:

Lot 14 Block 15 Lake Geneva Manor Subdivision of a portion of the City of Lake Geneva Walworth County, Wisconsin, Excepting therefrom the following described tract; Commencing at the southwesterly corner of said lot 14, thence southeasterly along the northerly line of said lot 14, 121.2 feet to a point in the westerly line of Lake Shore Drive, thence N. 17° 33' E., along said westerly line 15 feet to a point, thence northwesterly 120.2 feet to the place of beginning.

Certificate: I, hereby certify that I have on this the 2nd day of October 1947, surveyed the above described property according to the official records on file in the office of the Recorder of Deeds in and for Walworth County, Wisconsin, and find that the measurements and bearings of the boundary lines of said property as taken at the site on this day, substantially agree with those in the above description and that no encroachments exist.

SIGNED AND SEALED THIS 2ND DAY OF OCTOBER 1947.

Joseph M. Biagi
Joseph M. Biagi, Professional Engineer.
Elkhorn Wisconsin.