
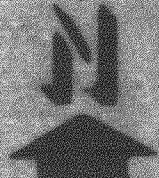


KOLB LAND CONSULTING, INC.
LAND SURVEYING • SUBDIVIDING • LAND PLANNING

25 WILLIAMS STREET LAKE GENEVA, WISCONSIN 53147 414-248-3697

GROVE ST.

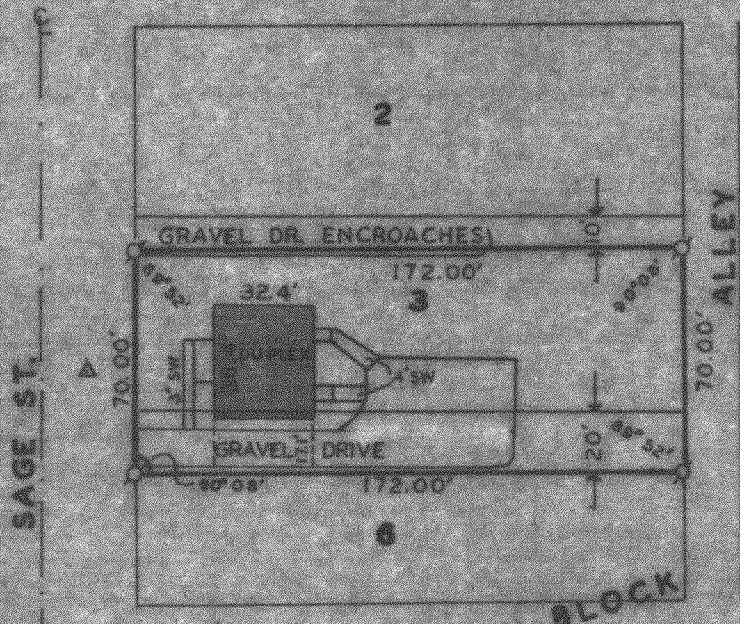

SCALE: 1" = 60'

LEGEND

- ⊙- IRON PIPE FOUND
- Δ- POWER POLE
- SW- SIDE WALK

PLAT OF SURVEY OF

LOT 3, EXCEPT THE NORTH 10 FEET THEREOF, AND THE NORTH 20 FEET OF LOT 6, BLOCK 8, GENEVA LAKE CRAWFORD MANUFACTURING COMPANY ADDITION, CITY OF LAKE GENEVA, WALWORTH COUNTY, WISCONSIN.

FOR: NATIONAL SAVINGS
PO BOX 13427
WAUWATOSA, WI. 53213

I HEREBY CERTIFY THAT I HAVE SURVEYED THE ABOVE DESCRIBED PROPERTY AND THAT THE ABOVE MAP IS A TRUE REPRESENTATION THEREOF AND SHOWS THE SIZE AND LOCATION OF THE PROPERTY, ITS EXTERIOR BOUNDARIES, THE LOCATION OF ALL VISIBLE STRUCTURES AND DIMENSIONS OF ALL PRINCIPAL BUILDINGS THEREON, BOUNDARY FENCES, APPARENT EASEMENTS, ROADWAYS, AND VISIBLE ENCROACHMENTS, IF ANY, TO THE BEST OF MY KNOWLEDGE AND BELIEF. THIS SURVEY IS MADE FOR THE USE OF THE PRESENT OWNERS OF THE PROPERTY, AND ALSO THOSE WHO PURCHASE, MORTGAGE, OR GUARANTEE THE TITLE THERETO WITHIN ONE(1) YEAR FROM DATE HEREOF.



Harold H. Kolb

HAROLD H. KOLB

WISCONSIN REGISTERED LAND SURVEYOR, S-187

DATE JUNE 10, 1985

REVISED _____

REVISED _____

2GC-00031A

7-779-K