


CSM 916 BAGS.

FARRIS, HANSEN & ASSOCIATES INC.

7 RIDGEWAY CT. P.O. BOX 487

ELKHORN, WIS. 414-723-2098

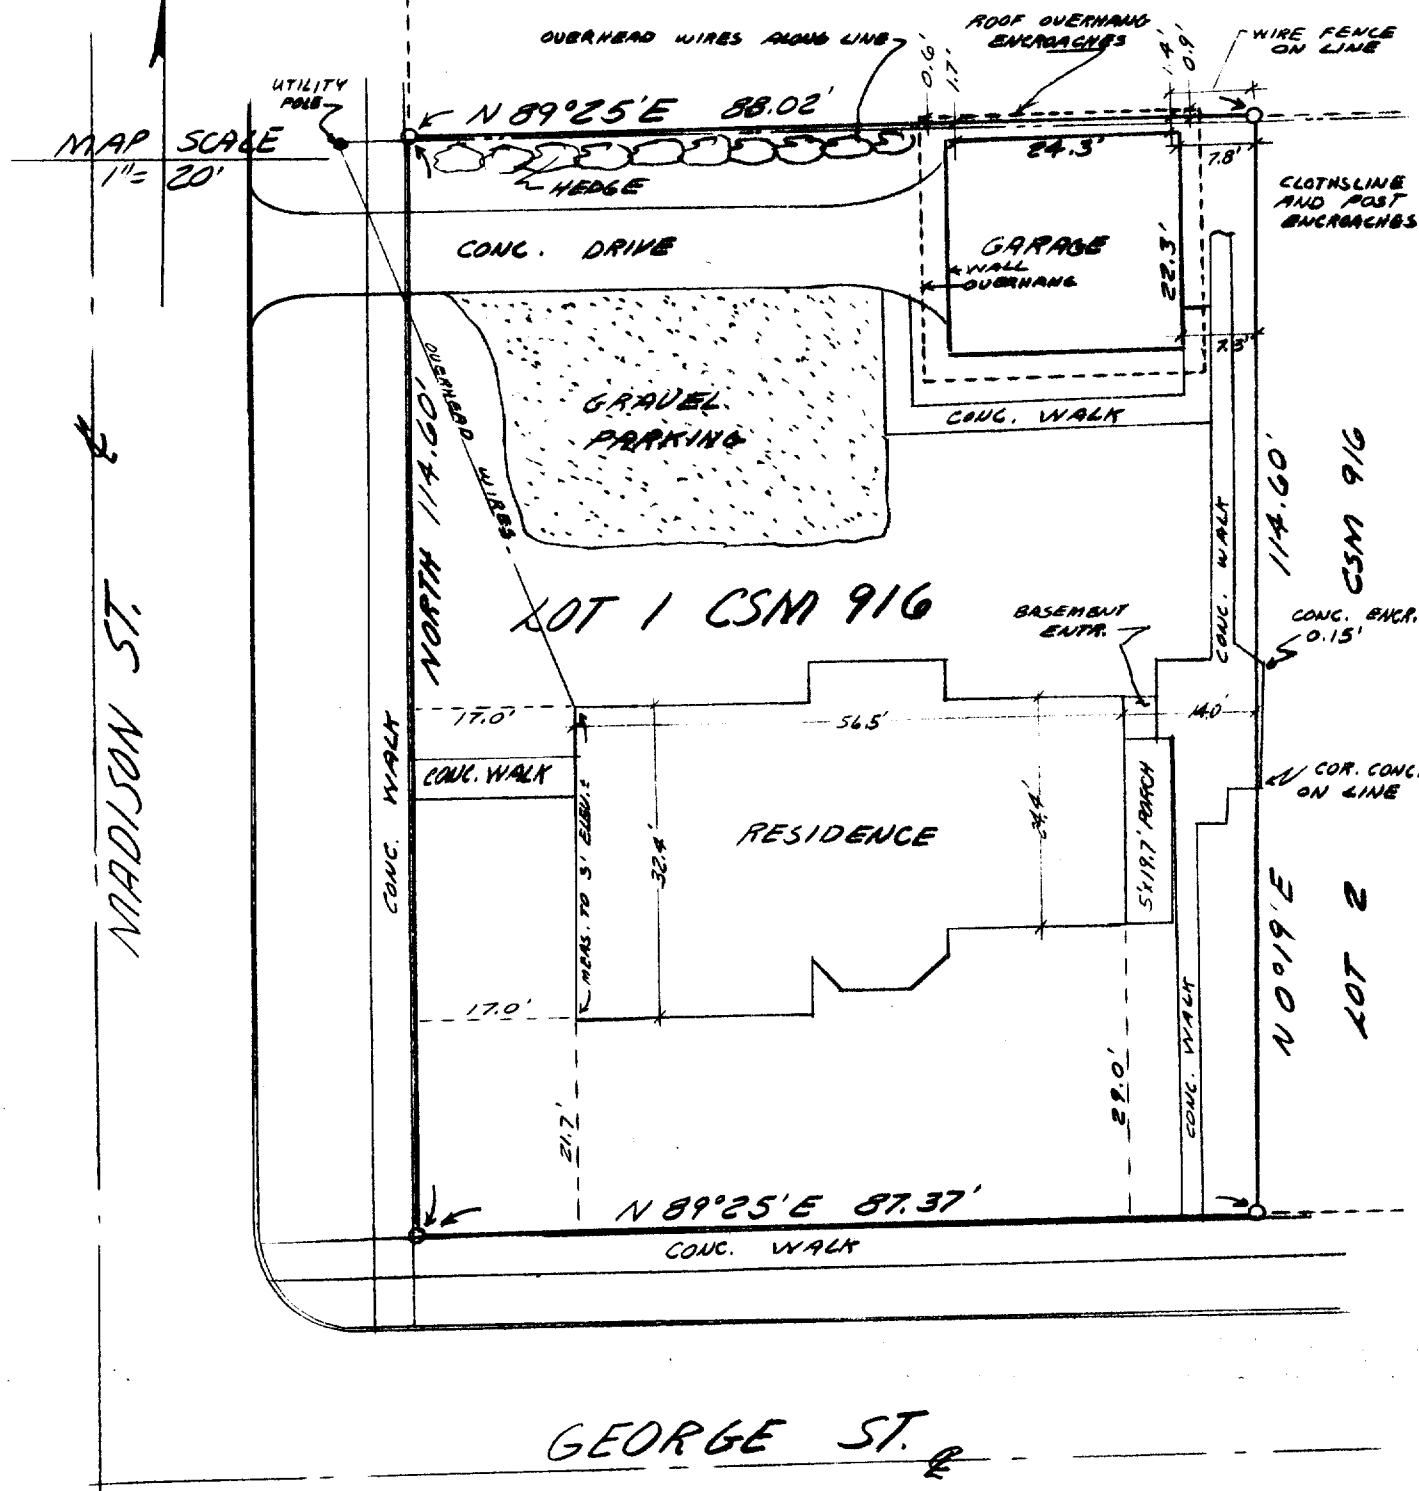

PLAT OF SURVEY OF LOT 1 OF CSM 916 LOCATED
IN SW 1/4 SEC. 25, T. 2N, R. 17E, CITY OF LAKE
GENEVA, WALWORTH CO., WISCONSIN

I hereby certify that I have surveyed the above described property and that the above map is a true representation thereof and shows the size and location of the property, its exterior boundaries, the location of all visible structures and dimensions of all principal buildings thereon, boundary fences, apparent easements, roadways and visible encroachments, if any.


This survey is made for the use of the present owners of the property, and also those who purchase, mortgage, or guarantee the title thereto within one (1) year from the date hereof.

ORDERED BY: KEEFE & ASSOCIATES

SELLER: JOSEPH KETTERHAGEN

BUYER: KURT STIER

Robert A. Farris

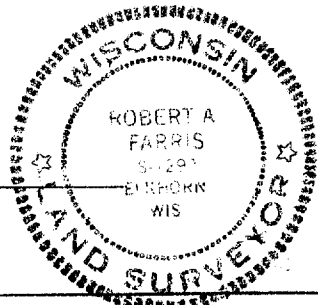

DATED 5/21/85

0 = IRON PIPE SURVEY STAKE
PROJECT NO. 2412

7-780 ✓