
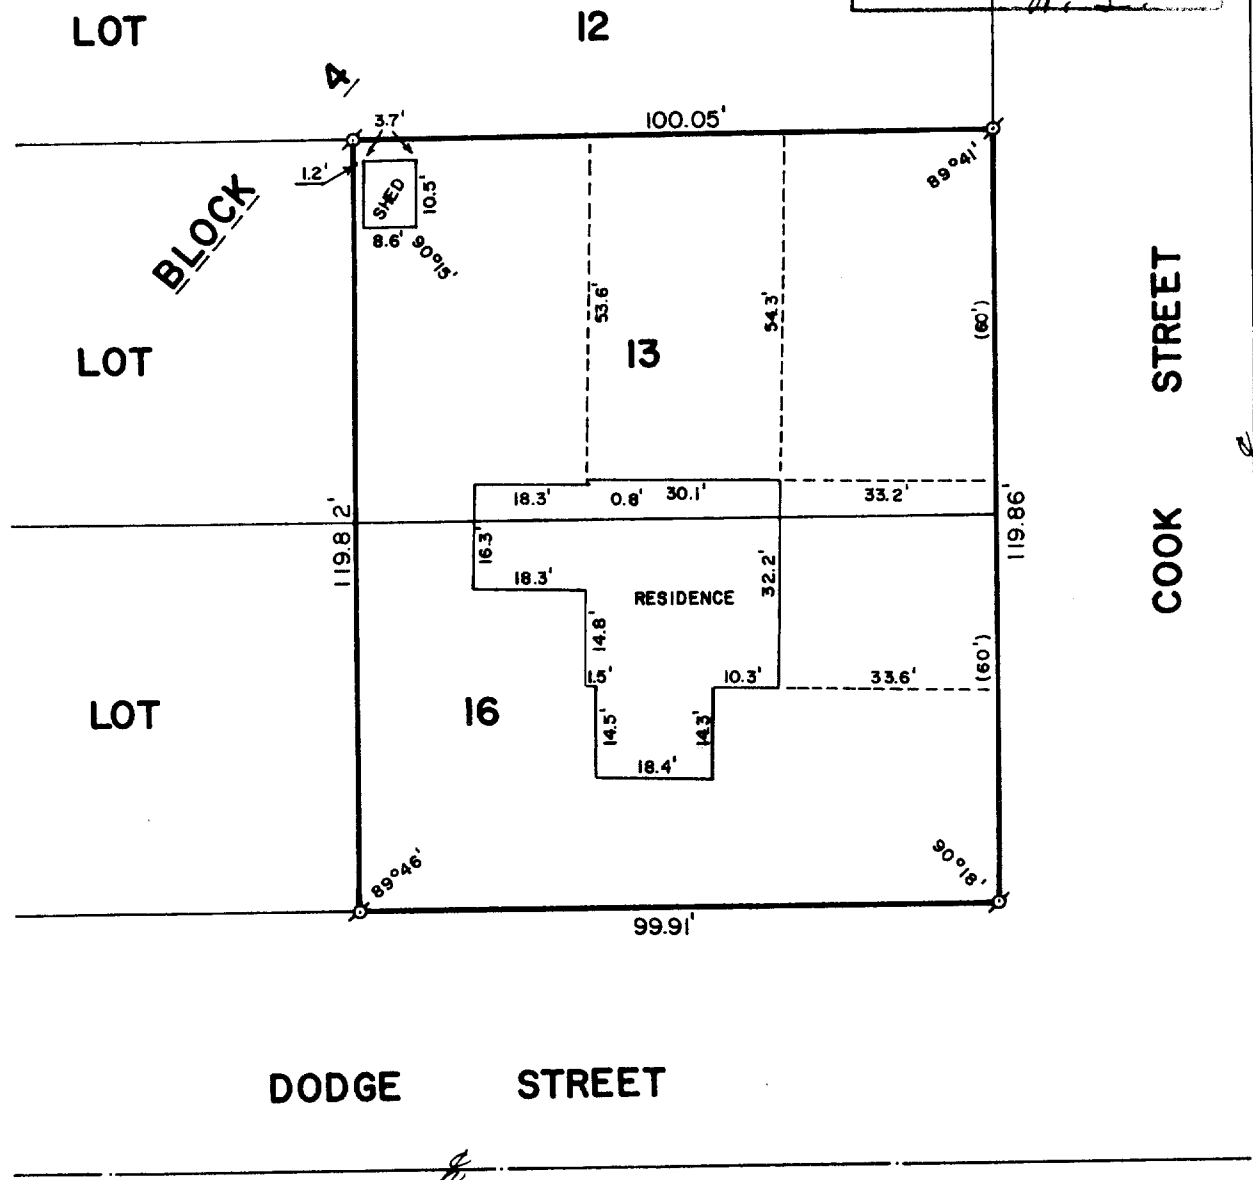


WALWORTH COUNTY
SURVEYING & MAPPING
LAKE GENEVA, WISCONSIN

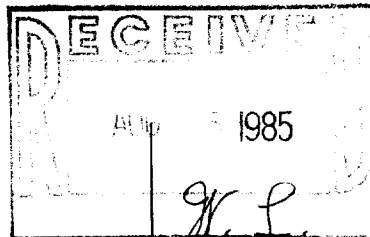

PLAT OF SURVEY OF

THE EAST 100 FEET OF LOTS 13 AND 16, BLOCK
4 OF GOODSSELL'S SUBDIVISION, CITY OF LAKE
GENEVA, WALWORTH COUNTY, WISCONSIN AS FOUND
TO BE MONUMENTED.

ORDERED BY: STURGE TAGGART AGENCY
736 MAIN STREET
LAKE GENEVA, WISCONSIN 53147



I, ROBERT M. BAERENWALD, DO HEREBY CERTIFY THAT I
HAVE SURVEYED THE PROPERTY HEREON DESCRIBED ACCORDING
TO THE OFFICIAL RECORDS AND THAT THE PLAT HEREON IS A
CORRECT REPRESENTATION OF THE PROPERTY LINES TO THE
BEST OF MY KNOWLEDGE AND BELIEF.

Robert M. Baerenwald
ROBERT M. BAERENWALD
WISCONSIN REGISTERED LAND SURVEYOR, S-1508

DATE *May 11, 1985* JOB NO. 0271



SCALE: 1"=50'

Ø-IRON PIPE FOUND
()-RECORDED AS

2GD-00024

7-780-134