


WALWORTH COUNTY
SURVEYING & MAPPING
LAKE GENEVA, WISCONSIN

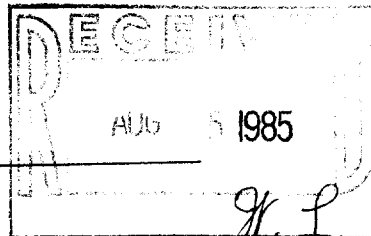


ANN STREET

66' WIDE


WILLIAMS STREET

60' WIDE

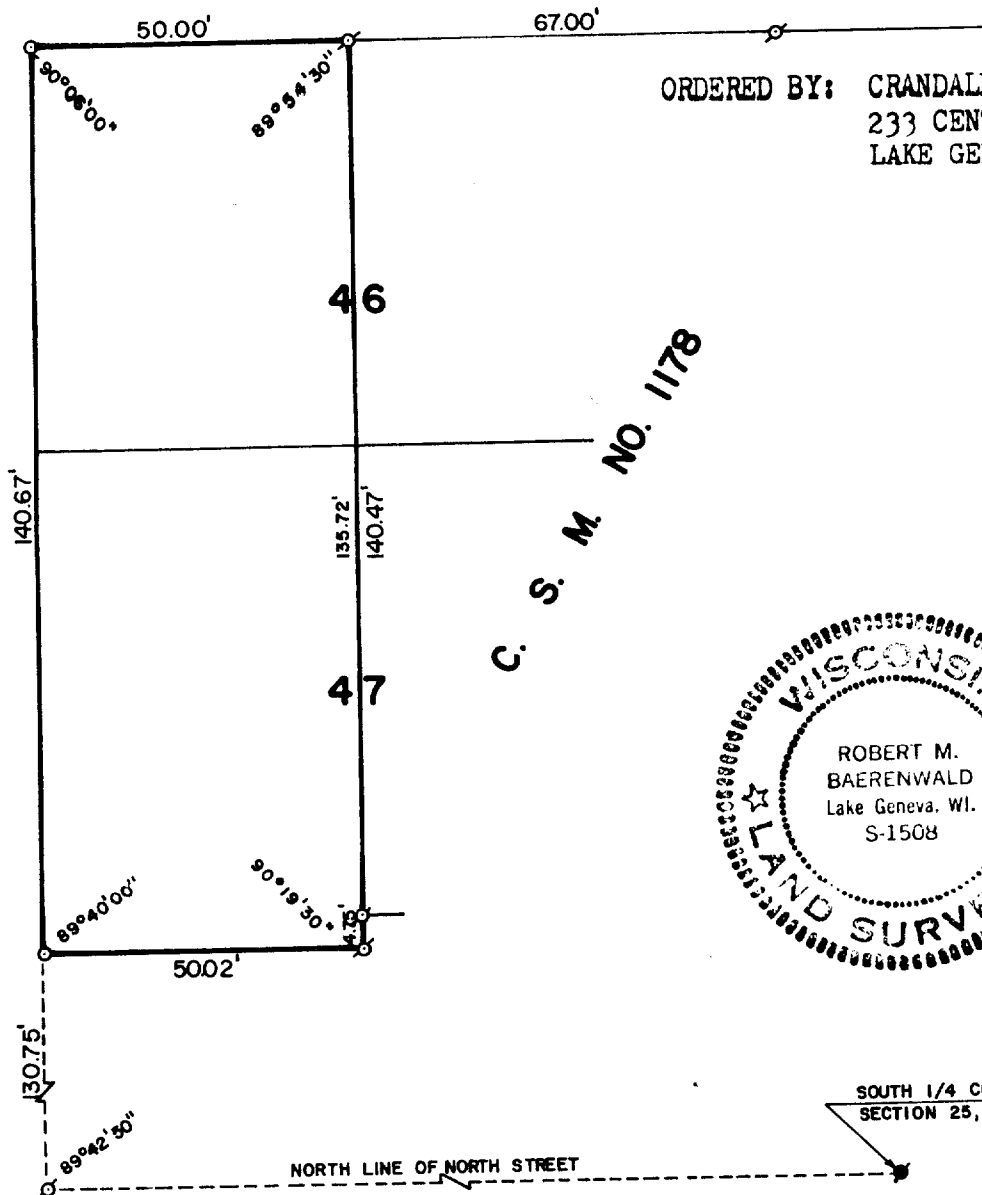

ORDERED BY: CRANDALL & THOMAS
233 CENTER STREET
LAKE GENEVA, WISCONSIN
53147

C. S. M. NO. 1178

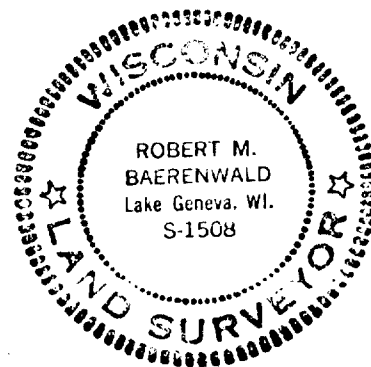

SOUTH 1/4 CORNER
SECTION 25, T2N, R17E

NORTH STREET

PLAT OF SURVEY OF

A PARCEL OF LAND LOCATED IN LOTS 46 AND 47 OF FERGUSON'S ADDITION TO THE VILLAGE (NOW CITY) OF LAKE GENEVA, WALWORTH COUNTY, WISCONSIN AND DESCRIBED AS FOLLOWS: BEGINNING AT THE NORTHWEST CORNER OF LOT 46 OF FERGUSON'S ADDITION TO THE VILLAGE (NOW CITY) OF LAKE GENEVA, THENCE SOUTH ALONG THE EAST LINE OF WILLIAMS STREET TO A POINT 130.75 FEET NORTH OF THE NORTH LINE OF NORTH STREET; THENCE EAST 50 FEET; THENCE NORTH PARALLEL TO THE EAST LINE OF WILLIAMS STREET TO THE SOUTH LINE OF ANN STREET; THENCE WEST ALONG THE SOUTH LINE OF ANN STREET TO THE PLACE OF BEGINNING.



SCALE: 1"=30'

- o - IRON PIPE FOUND
- o - IRON PIPE PLACED
- - CONCRETE MONUMENT FOUND

I, ROBERT M. BAERENWALD, DO HEREBY CERTIFY THAT I HAVE SURVEYED THE PROPERTY HEREON DESCRIBED ACCORDING TO THE OFFICIAL RECORDS AND THAT THE PLAT HEREON IS A CORRECT REPRESENTATION OF THE PROPERTY LINES TO THE BEST OF MY KNOWLEDGE AND BELIEF.

Robert M. Baerenwald
ROBERT M. BAERENWALD
WISCONSIN REGISTERED LAND SURVEYOR, S-1508

DATE May 7, 1985 JOB NO. 0265

2F-44

7-784-B