


KOLB LAND CONSULTING, INC.
LAND SURVEYING • SUBDIVIDING • LAND PLANNING

929 WILLIAMS STREET LAKE GENEVA, WISCONSIN 53147 414-248-3697

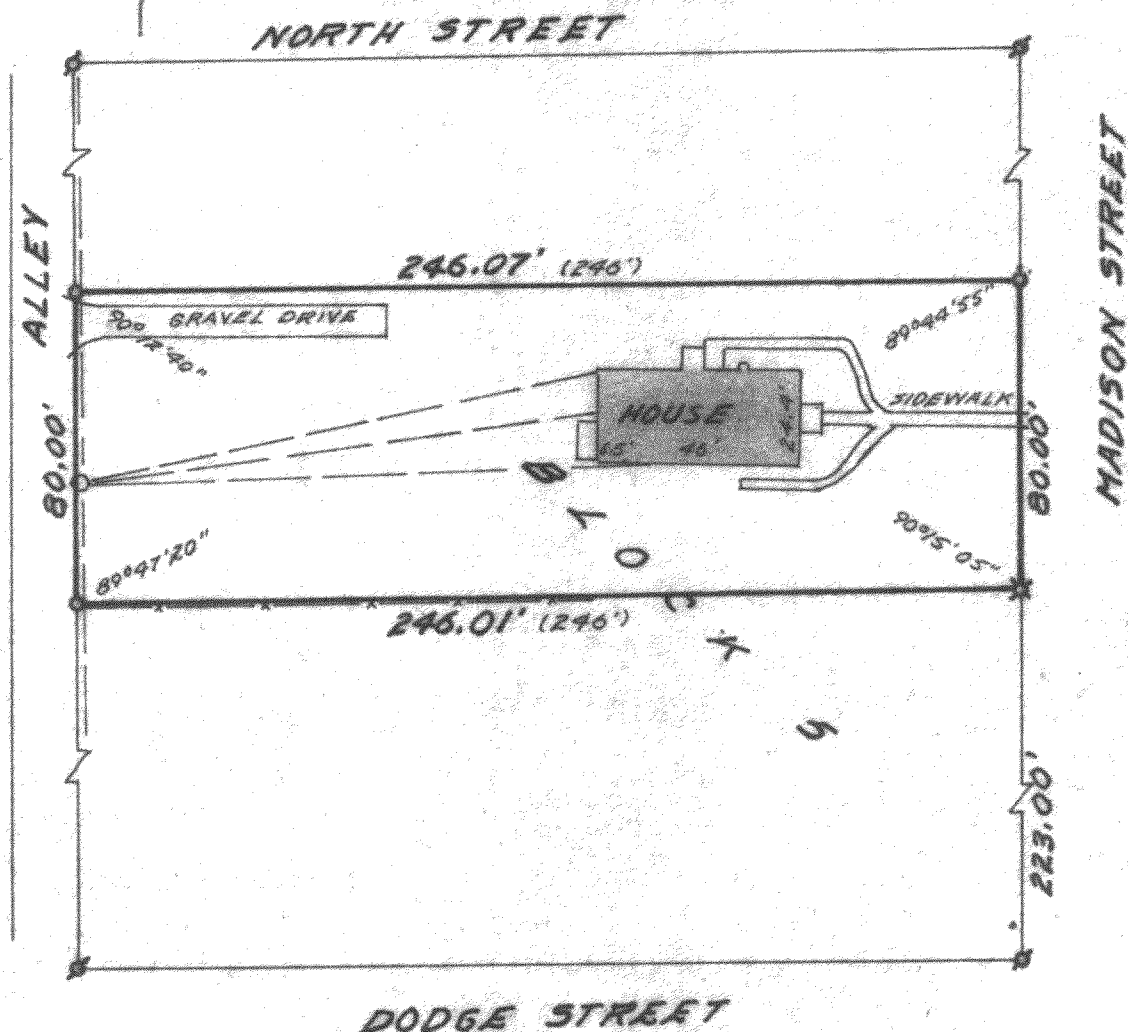

PLAT OF SURVEY OF
A PARCEL OF LAND LOCATED IN BLOCK 5, ORIGINAL PLAT OF THE
VILLAGE, NOW CITY, OF LAKE GENEVA, WALWORTH COUNTY, WI.
TAX PARCEL: OP-36

ORDERED BY:
KENOSHA SAVINGS & LOAN ASSOCIATION
410 BROAD STREET
LAKE GENEVA, WI. 53147



SCALE: 1" = 50'

I HEREBY CERTIFY THAT I HAVE SURVEYED THE
ABOVE DESCRIBED PROPERTY AND THAT THE ABOVE
MAP IS A TRUE REPRESENTATION THEREOF AND
SHOWS THE SIZE AND LOCATION OF THE PROPERTY,
ITS EXTERIOR BOUNDARIES, THE LOCATION OF ALL
VISIBLE STRUCTURES AND DIMENSIONS OF ALL
PRINCIPAL BUILDINGS THEREON, BOUNDARY FENCES,
APPARENT EASEMENTS, ROADWAYS AND VISIBLE
ENCROACHMENTS, IF ANY, TO THE BEST OF MY
KNOWLEDGE AND BELIEF.
THIS SURVEY IS MADE FOR THE USE OF THE
PRESENT OWNERS OF THE PROPERTY, AND ALSO
THOSE WHO PURCHASE, MORTGAGE, OR GUARANTEE
THE TITLE THERETO WITHIN ONE (1) YEAR FROM
THE DATE HEREOF.

- LEGEND
- IRON PIPE FOUND
 - ✱ IRON ROD FOUND
 - (246') AS RECORDED
 - UTILITY POLE
 - OVERHEAD UTILITY LINES
 - FENCE
 - 1" X 24" IRON PIPE SET

Harold H. Kolb
HAROLD H. KOLB

WISCONSIN REGISTERED LAND SURVEYOR, S-187

DATE MAY 8, 1985

REVISED

REVISED

ZOP-00036

LG-561

7-786-K