



WALWORTH COUNTY
SURVEYING & MAPPING
LAKE GENEVA, WISCONSIN

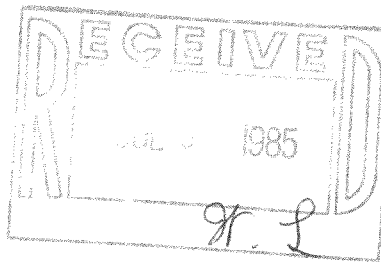



WALWORTH STREET
66' WIDE

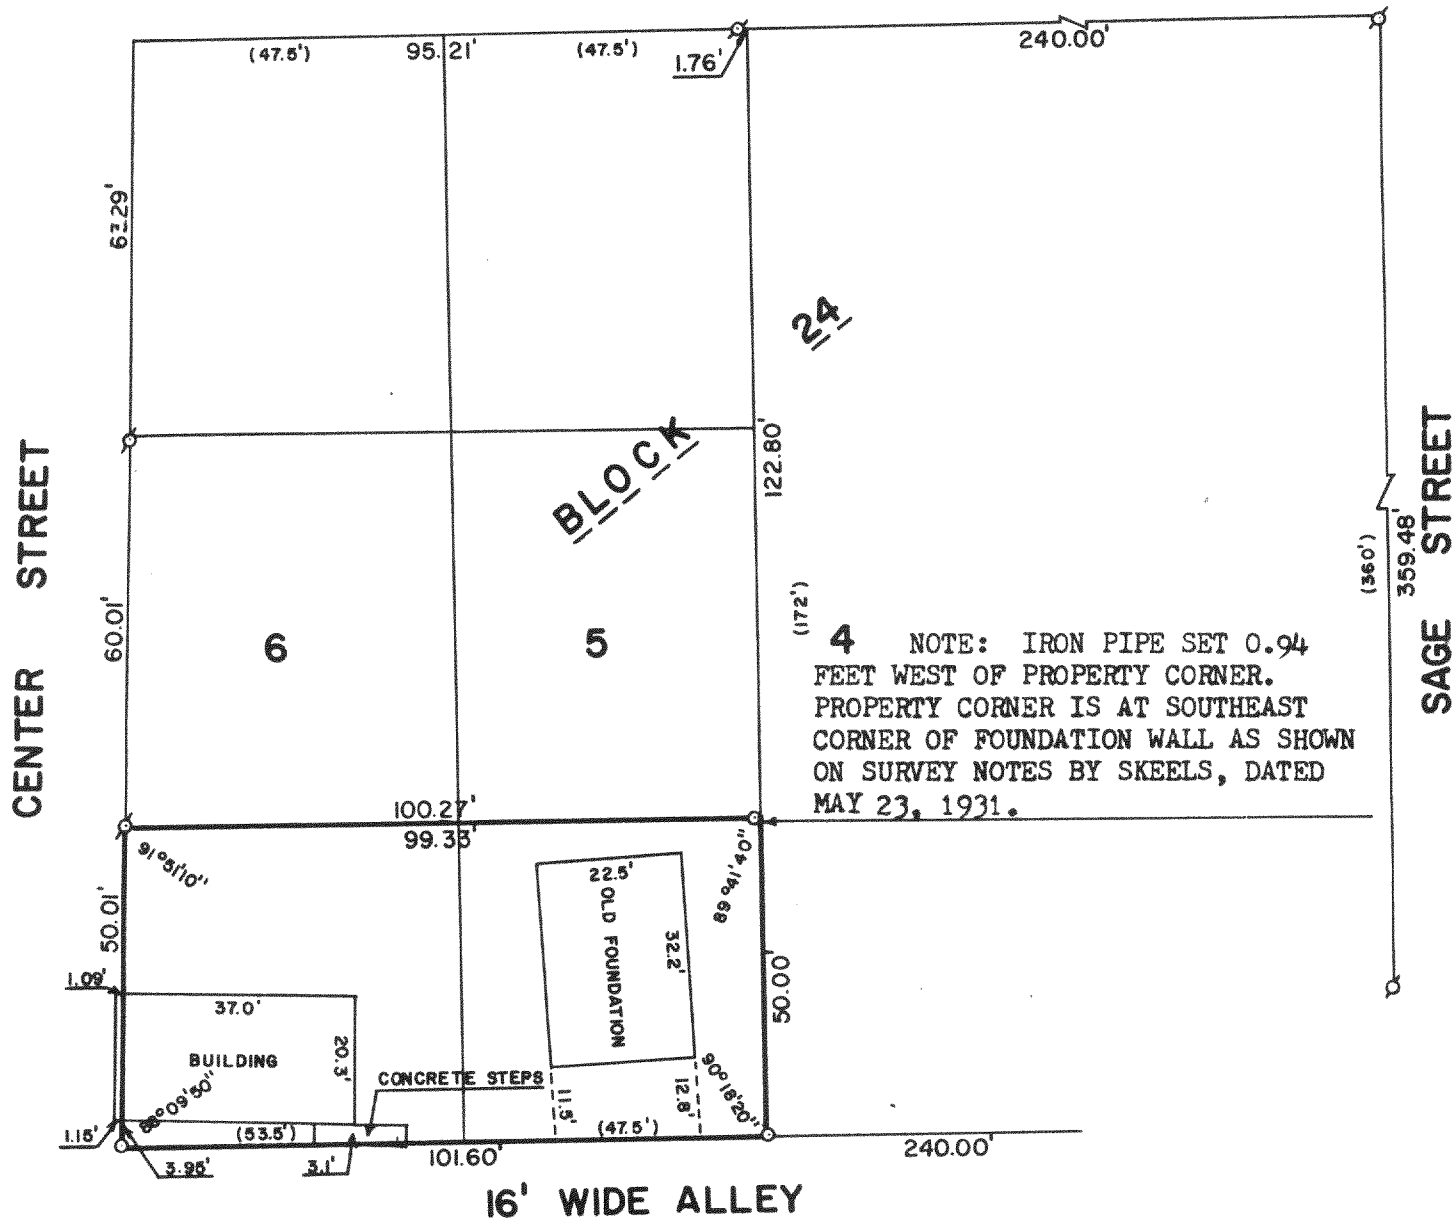

PLAT OF SURVEY OF

THE SOUTH 50 FEET OF LOTS 5 AND 6, BLOCK 24 OF GENEVA LAKE CRAWFORD MANUFACTURING COMPANY SUBDIVISION, LOCATED IN THE CITY OF LAKE GENEVA, WALWORTH COUNTY, WISCONSIN.

ORDERED BY: COLDWELL BANKER, GENEVA LAKES AREA REALTORS
838 MAIN STREET
LAKE GENEVA, WISCONSIN 53147

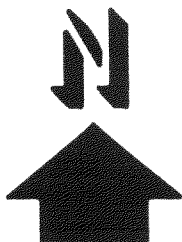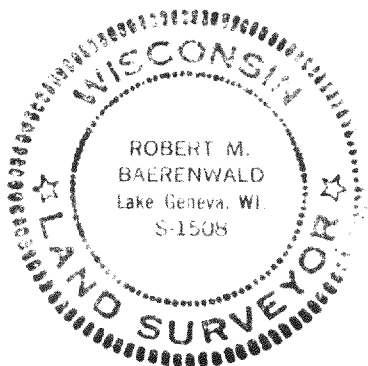

SCALE: 1"=30'

- o - IRON PIPE FOUND
- o - IRON ROD FOUND
- o - IRON PIPE PLACED
- () - RECORDED AS

I, ROBERT M. BAERENWALD, DO HEREBY CERTIFY THAT I HAVE SURVEYED THE PROPERTY HEREON DESCRIBED ACCORDING TO THE OFFICIAL RECORDS AND THAT THE PLAT HEREON IS A CORRECT REPRESENTATION OF THE PROPERTY LINES TO THE BEST OF MY KNOWLEDGE AND BELIEF.

Robert M. Baerenwald
ROBERT M. BAERENWALD

DATE Aug. 29, 1984

JOB NO. 0109

ZGC-00148

7-787v