


RECEIVED
SEP 30 1985

KOLB LAND CONSULTING, INC.
LAND SURVEYING • SUBDIVIDING • LAND PLANNING

929 WILLIAMS STREET LAKE GENEVA, WISCONSIN 53147

RECEIVED
SEP 30 1985
H. L.

MAXWELL ST. 80' WIDE

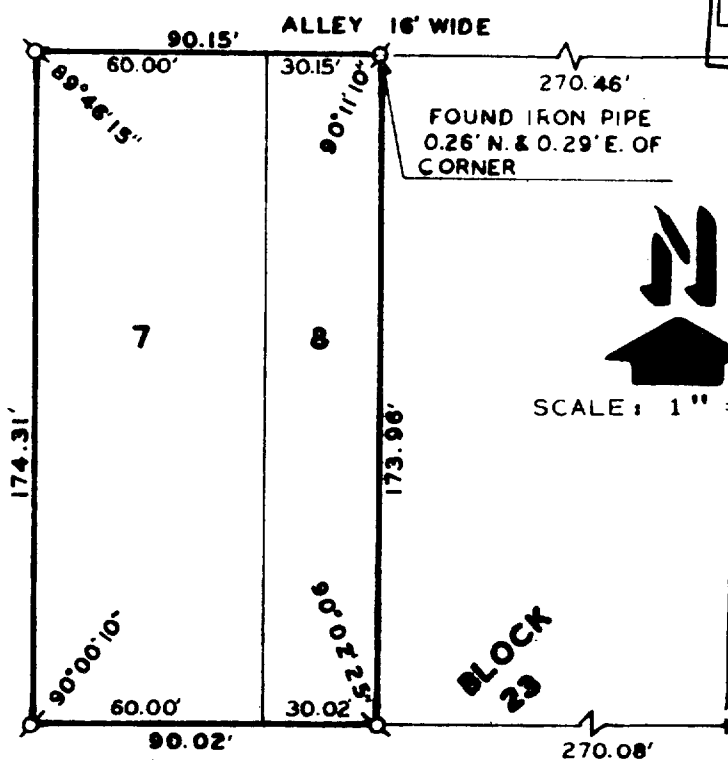

SCALE: 1" = 50'

LEGEND

- Ø - IRON PIPE FOUND
- + - SPIKE FOUND

ORDERED BY: DOROTHY DAHLIN

1131 MAIN ST.

LAKE GENEVA, WI, 53147

PLAT OF SURVEY OF

LOT 7 AND THE WEST 1/2 OF LOT 8, BLOCK 23,
ORIGINAL PLAT OF THE CITY OF LAKE GENEVA,
WALWORTH COUNTY, WISCONSIN.



I, HAROLD H. KOLB, DO HEREBY CERTIFY THAT
I HAVE SURVEYED THE PROPERTY HEREON DES-
CRIBED ACCORDING TO THE OFFICIAL RECORDS,
AND THAT THE PLAT HEREON IS A CORRECT REP-
RESENTATION OF THE LOT LINES TO THE BEST
OF MY KNOWLEDGE AND BELIEF.

Harold H. Kolb
HAROLD H. KOLB

WISCONSIN REGISTERED LAND SURVEYOR, S-187

DATE AUGUST 9, 1985

REVISED _____

REVISED _____

ZOP-00219

LG-ZOP-219 7-787-K