
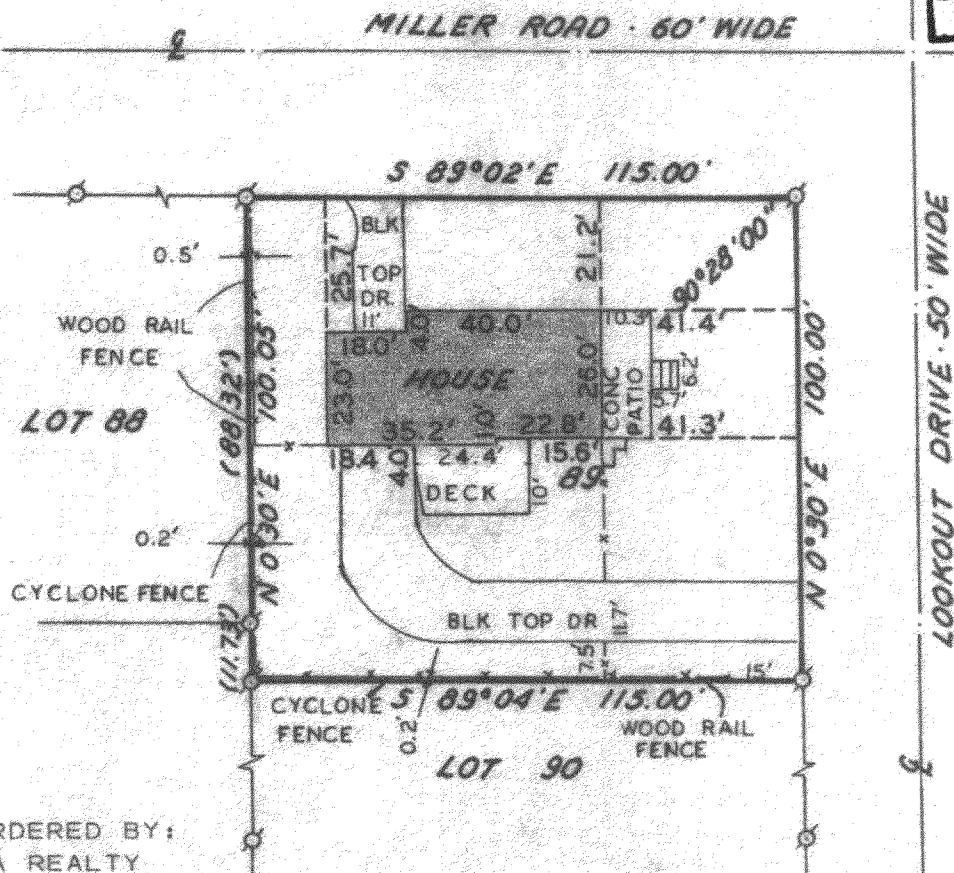


HAROLD H. KOLB

REGISTERED PROFESSIONAL LAND SURVEYOR
LAKE GENEVA, WISCONSIN

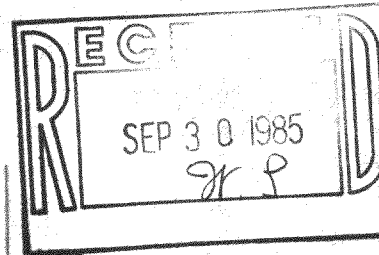

REVISION ORDERED BY:
LAKE GENEVA REALTY
737 MAIN ST.
LAKE GENEVA, WI. 53147

PLAT OF SURVEY OF

N



SCALE: 1"=40'

LEGEND

- ⊕ - IRON PIPE FOUND
- - IRON PIPE PLACED
- - CONCRETE MONUMENT
- x - SPIKE
- () - RECORDED AS

LOT 89, STURWOOD ADDITION NO. 3, CITY OF
LAKE GENEVA, WALWORTH COUNTY, WISCONSIN.


OWNER: HARRY BECKER

ACCURACY: DISTANCES: $\pm 0.01'$
ANGLES: $\pm 05''$
ERROR OF CLOSURE: LESS THAN ONE
PART IN 3,000

I, HAROLD H. KOLB, DO HEREBY CERTIFY THAT I HAVE
SURVEYED THE PROPERTY HEREON DESCRIBED ACCORDING
TO THE OFFICIAL RECORDS, AND THAT THE PLAT HEREON
IS A CORRECT REPRESENTATION OF THE LOT LINES, AND
THE PRINCIPLE BUILDING LINES THEREON.

Harold H. Kolb
HAROLD H. KOLB
WISCONSIN REGISTERED LAND SURVEYOR, S-187
DATE March 18, 1976

REVISED: JUNE 5, 1985

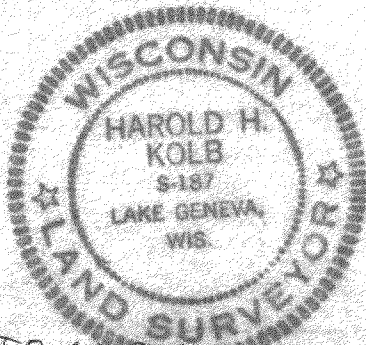

ZST3-00024

7-788-K