



WALWORTH COUNTY
SURVEYING & MAPPING
LAKE GENEVA, WISCONSIN

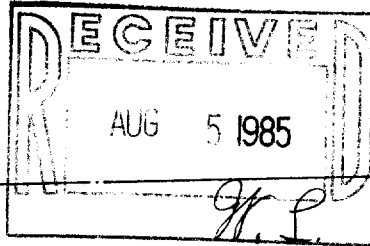

CASS STREET


SOUTH LAKE SHORE DRIVE
(WILLOW STREET)

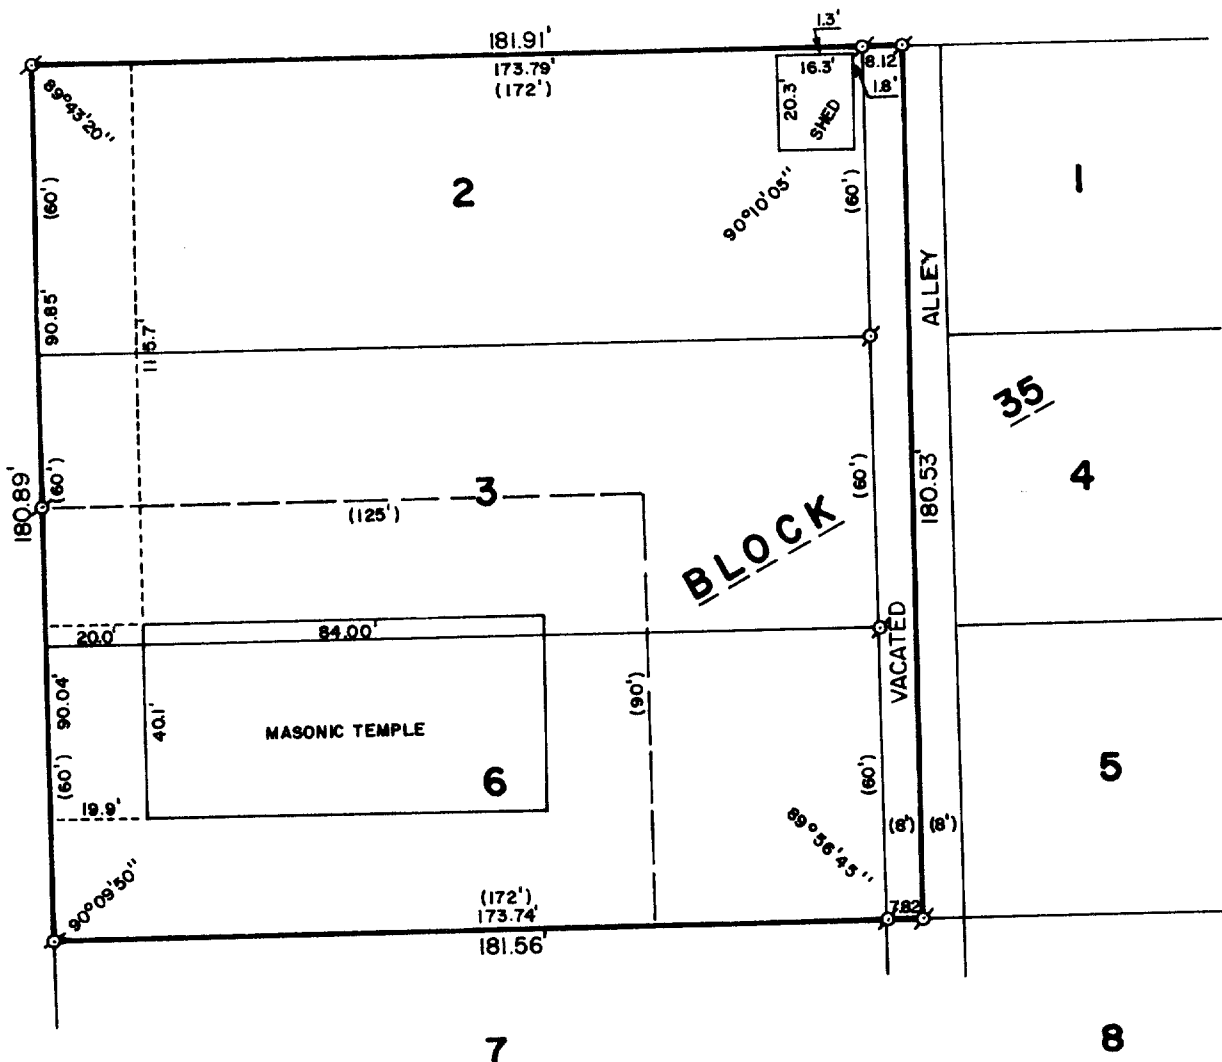

PLAT OF SURVEY OF

LOTS 2, 3, 6 AND PART OF A VACATED
ALLEY, ALL LOCATED IN BLOCK 35 OF THE
ORIGINAL PLAT OF THE CITY OF LAKE
GENEVA, WALWORTH COUNTY, WISCONSIN.

ORDERED BY: CHARLES HEIDELMEIER
1300 MADISON STREET
LAKE GENEVA, WISCONSIN
53147

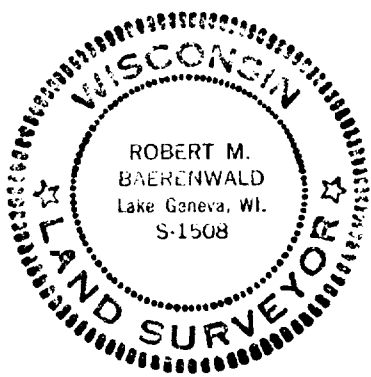

I, ROBERT M. BAERENWALD, DO HEREBY CERTIFY THAT I
HAVE SURVEYED THE PROPERTY HEREON DESCRIBED ACCORDING
TO THE OFFICIAL RECORDS AND THAT THE PLAT HEREON IS A
CORRECT REPRESENTATION OF THE PROPERTY LINES TO THE
BEST OF MY KNOWLEDGE AND BELIEF.

Robert M. Baerenwald
ROBERT M. BAERENWALD
WISCONSIN REGISTERED LAND SURVEYOR, S-1508

DATE July 9, 1985 JOB NO. 0287

SCALE: 1"=40'

σ-IRON PIPE FOUND
()-RECORDED AS

OP-359-A1

7-793A