



WALWORTH COUNTY
SURVEYING & MAPPING
LAKE GENEVA, WISCONSIN

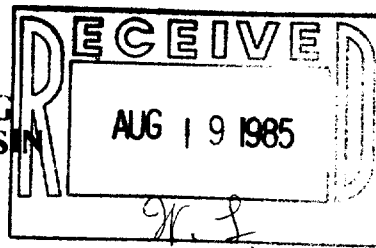

16' WIDE ALLEY

WARREN STREET

MADISON STREET

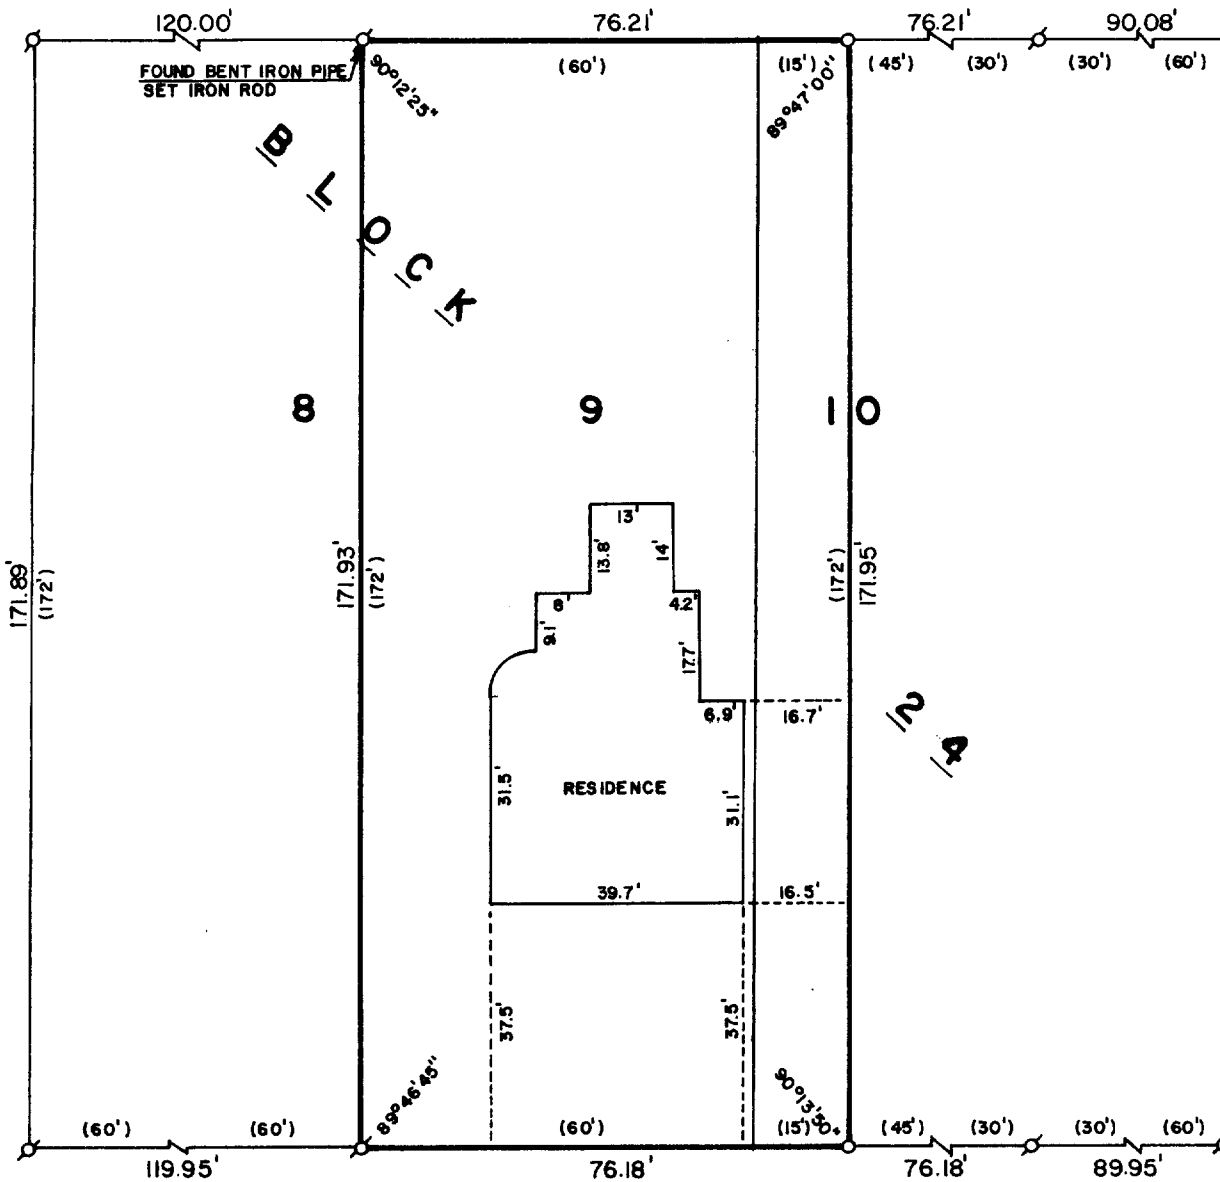


MAIN STREET

PLAT OF SURVEY OF

LOT 9 AND THE WESTERLY 15 FEET OF LOT 10,
BLOCK 24 OF THE ORIGINAL PLAT OF THE CITY
OF LAKE GENEVA, WALWORTH COUNTY, WISCONSIN.

ORDERED BY: BEA DALE
950 MOBILE STREET
LAKE GENEVA, WISCONSIN
53147

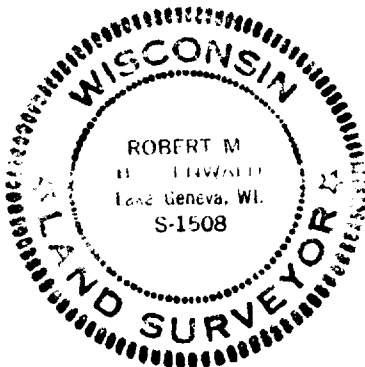

SCALE: 1"=30'

Ø - IRON PIPE FOUND
○ - IRON ROD PLACED
() - RECORDED AS

I, ROBERT M. BAERENWALD, DO HEREBY CERTIFY THAT I
HAVE SURVEYED THE PROPERTY HEREON DESCRIBED ACCORDING
TO THE OFFICIAL RECORDS AND THAT THE PLAT HEREON IS A
CORRECT REPRESENTATION OF THE PROPERTY LINES TO THE
BEST OF MY KNOWLEDGE AND BELIEF.

Robert M. Baerenwald
ROBERT M. BAERENWALD
WISCONSIN REGISTERED LAND SURVEYOR, S-1508

Aug. 17, 1985
DATE JOB NO. 0342

20P-00230

7-799-10