


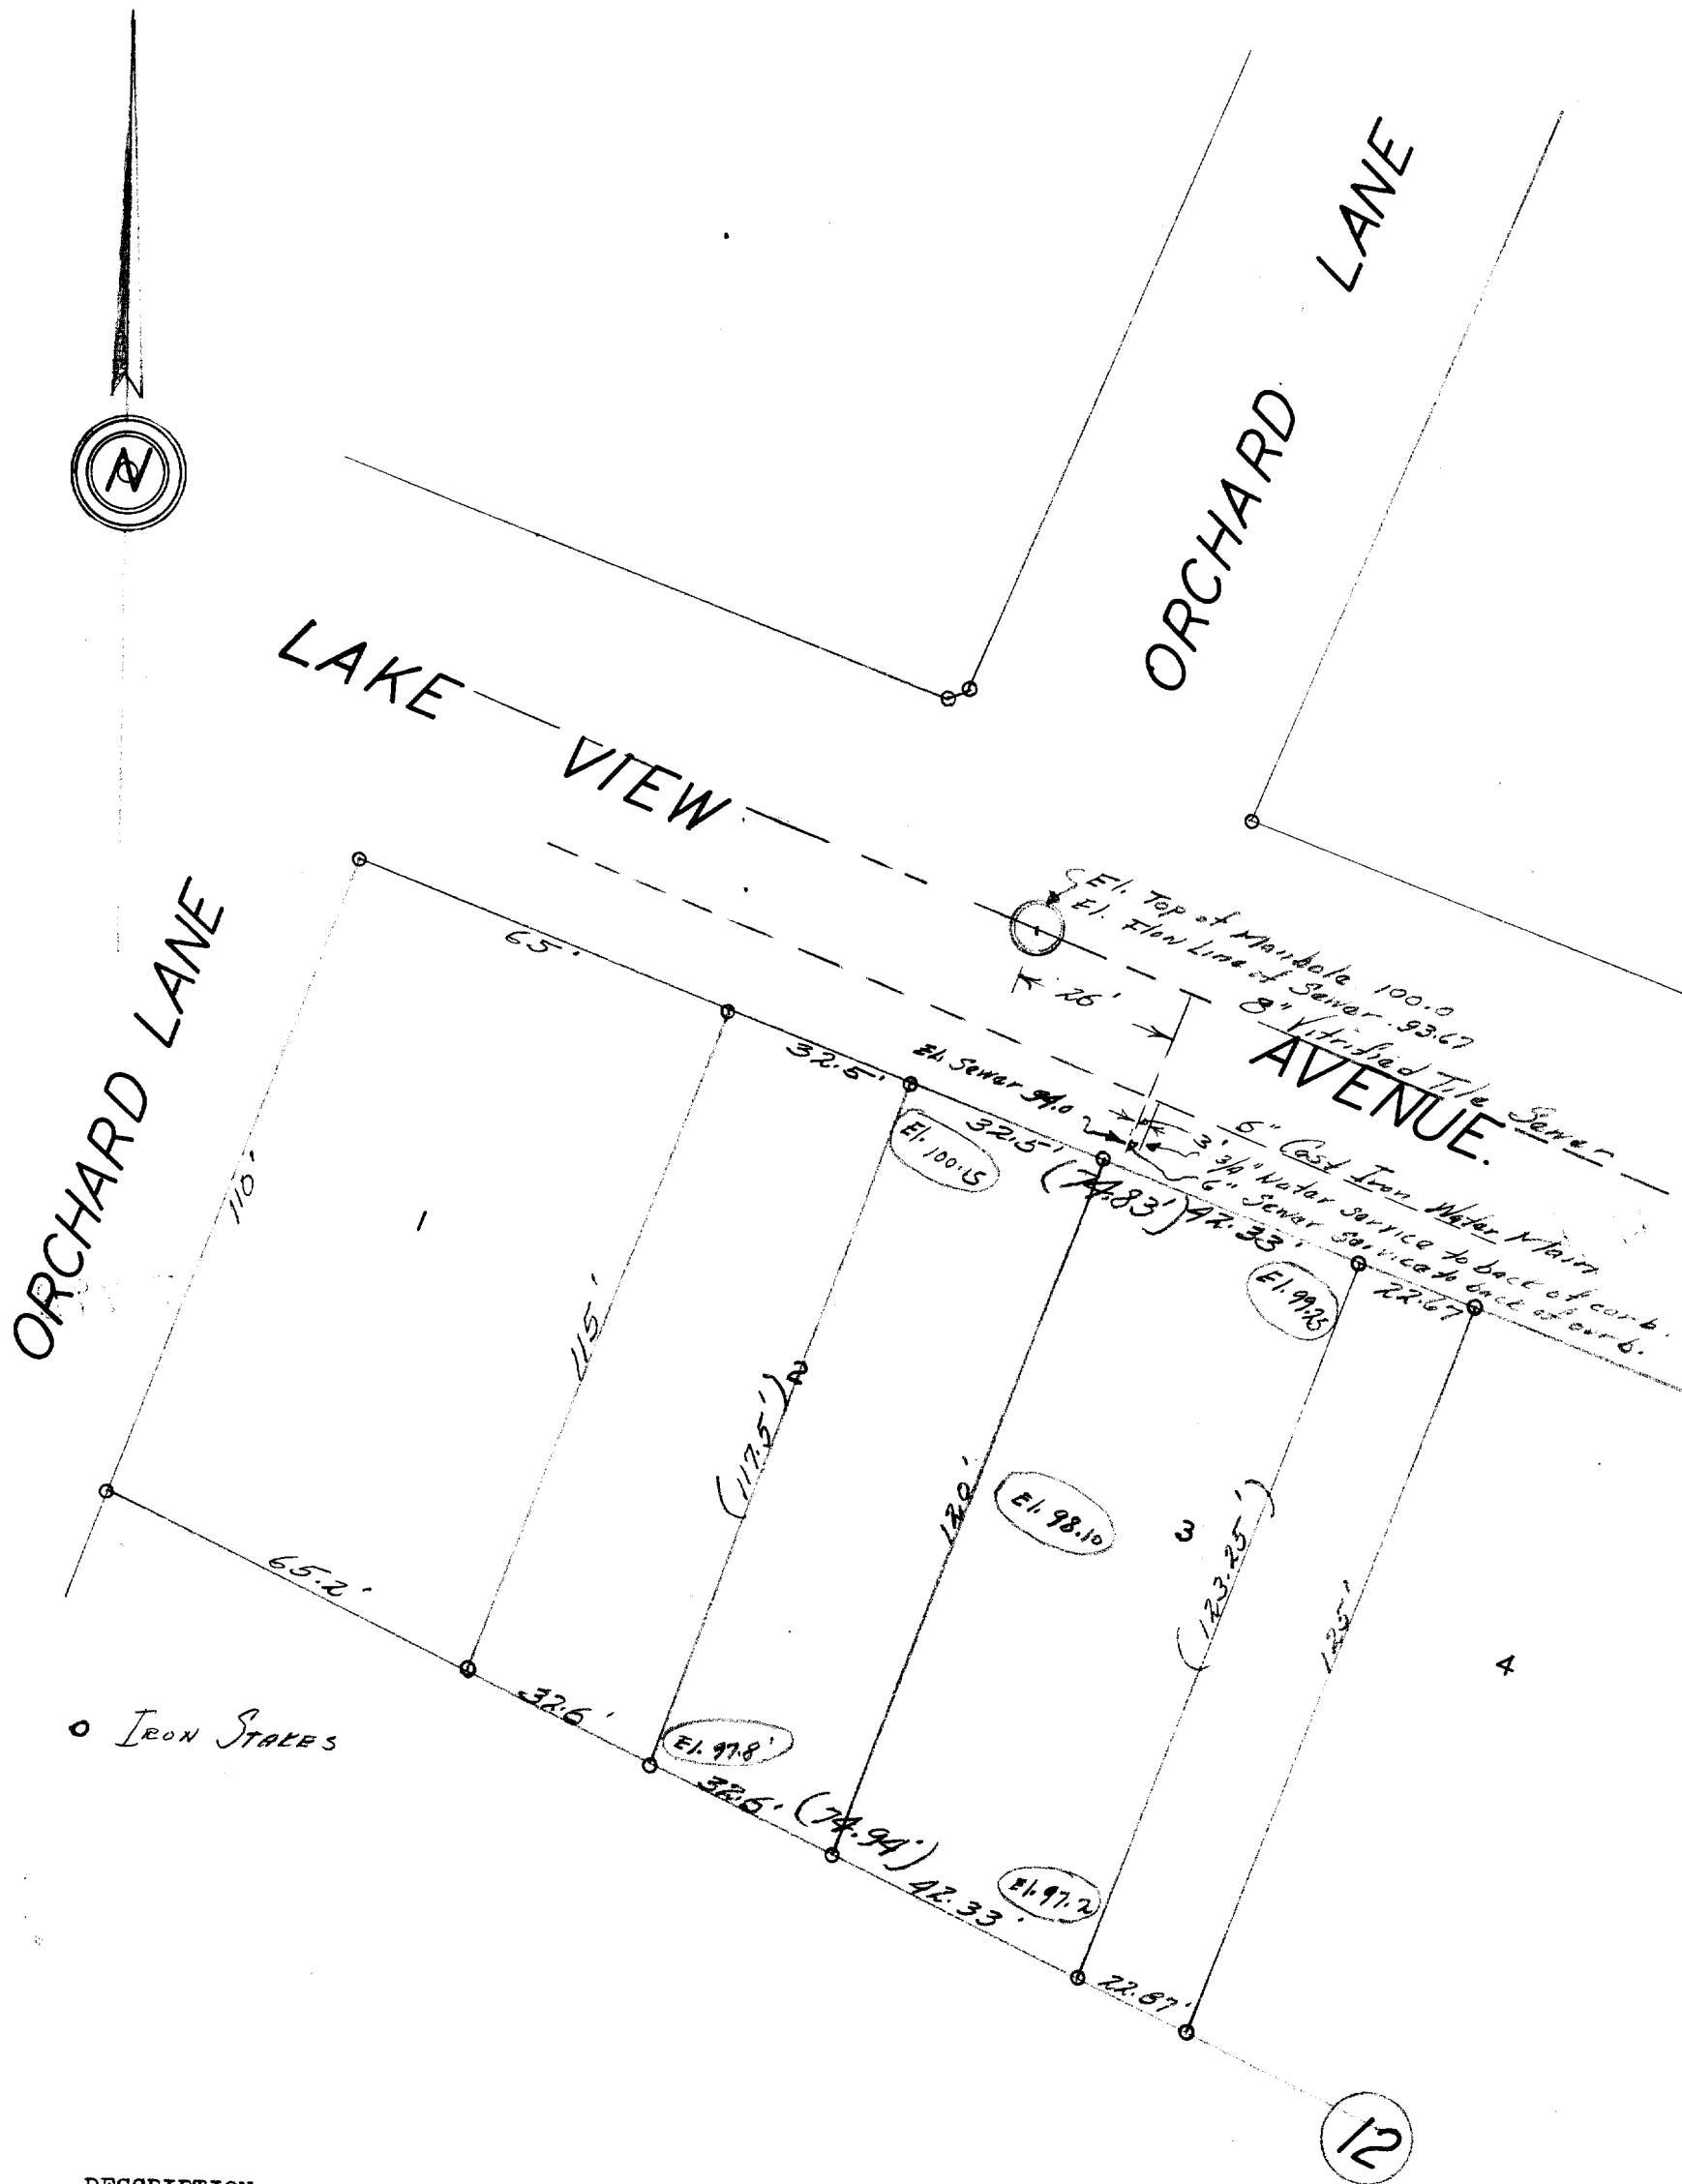

DESCRIPTION:

The southeasterly  $\frac{1}{2}$  of Lot 2 Block 12 and the northwesterly 42.33 feet of Lot 3 Block 12 of Lake Geneva Manor, Tract 17 City of Lake Geneva Walworth County, Wisconsin.

**CERTIFICATE:**

I, hereby certify that I have on this the 30th day of July 1949, surveyed the above described property according to the official records on file in the office of the Recorder of Deeds in and for Walworth County, Wisconsin, and find that the measurements and bearings of the boundary lines of said property as taken at the site on this day, substantially agree with those in said official record and that no encroachments exist.  
SIGNED AND SEALED THIS 8TH DAY OF AUGUST 1949.

2CM 3-5  
~~LM-3 & LM-4~~

Joseph M. Biagi. Professional Engineer.  
Elkhorn Wisconsin.

7-79 R