


NORTH 60 FEET OF LOTS 6 & 7 BLOCK 16 LOCATED IN
GENEVA LAKE CRAWFORD MANUFACTURING COMPANY'S ADDITION,
T2N, R1E, CITY OF LAKE GENEVA, WALWORTH COUNTY, WISCONSIN.

JENSEN SURVEYING & MAPPING S.C.
P.O. BOX 322 45 SOUTH WISC. ST.
ELKHORN, WISCONSIN 53121

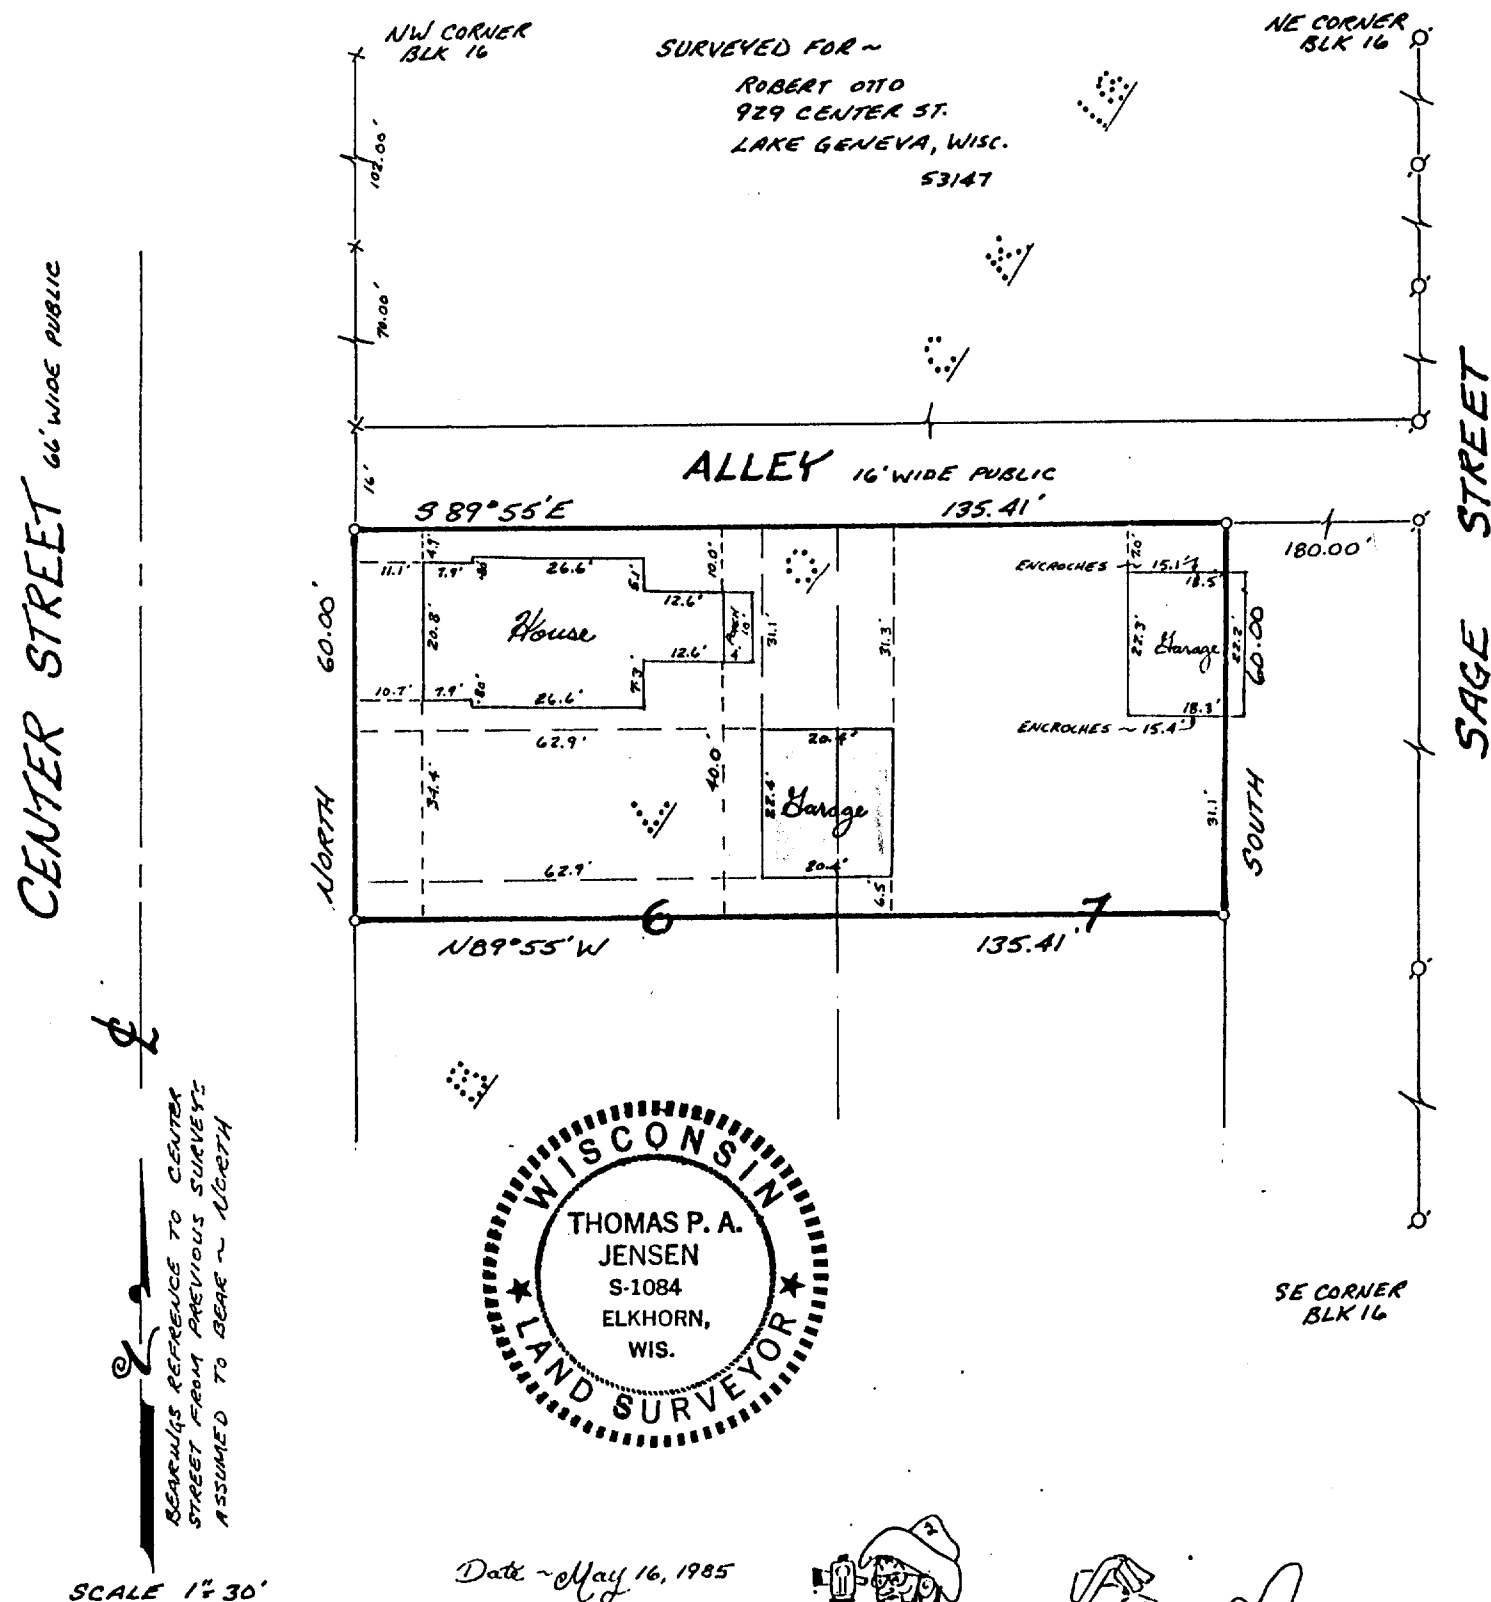

LEGEND

- S ~ FOUND 2" DIA. IRON PIPE
 S ~ FOUND 1" DIA IRON PIPE
 O ~ SET 3/4" DIA IRON ROD
 X ~ FOUND CHISEL CROSS CUT
 IN SIDEWALK

I, THOMAS P.A. JENSEN, WISC. REGISTERED
LAND SURVEYOR, DO HEREBY CERTIFY THAT THIS SURVEY
WAS PERFORMED BY ME OR UNDER MY DIRECTION, IN FULL
COMPLIANCE WITH THE OWNER'S / AGENT'S INSTRUCTIONS AND
CHAPTER AE-5 OF WISC. ADMIN. CODE "MINIMUM STANDARDS
FOR PROPERTY SURVEYS"; AND THAT THIS MAP IS AN ACCURATE
REPRESENTATION THEREOF TO THE BEST OF MY KNOWLEDGE AND BELIEF

THOMAS P.A. JENSEN S-1084

7-800-5