

PLAT OF SURVEY OF

LOT 11, COLUMBIAN SUBDIVISION, LOCATED
IN THE SW 1/4 OF SECTION 26, T2N, R1E,
CITY OF LAKE GENEVA, WALWORTH COUNTY, WISC.

Surveyed by ~

JENSEN SURVEYING & MAPPING S.C


P.O. BOX 322

45 S. WISCONSIN ST.

ELKHORN, WISCONSIN

53121

PHONE (414) 723-3434

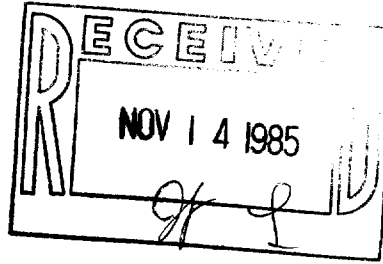

LEGEND

- ~ FOUND IRON PIPE
- ⊗ ~ SET IRON PIPE
- () ~ RECORDED AS


Surveyed for ~

RANDY LEECE


114 N. CHURCH ST.

ELKHORN, WIS.

Note ~ House & Garage, well
within lot lines

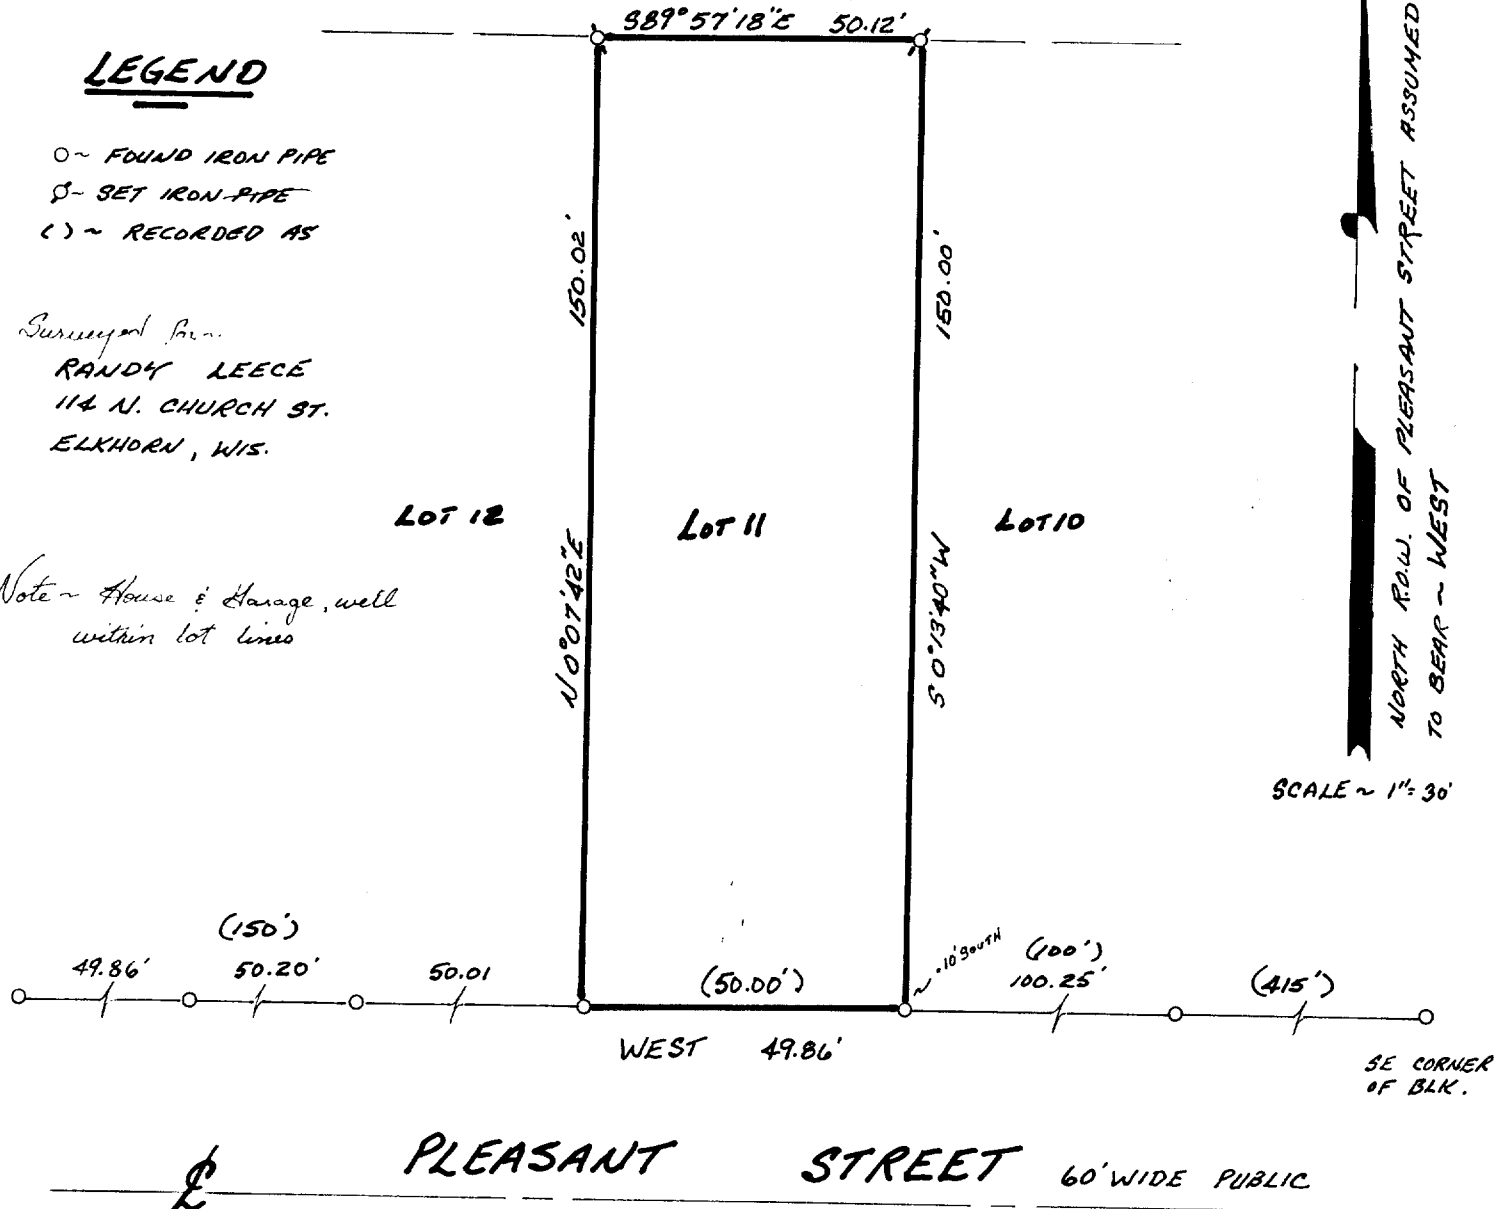

August 16, 1985

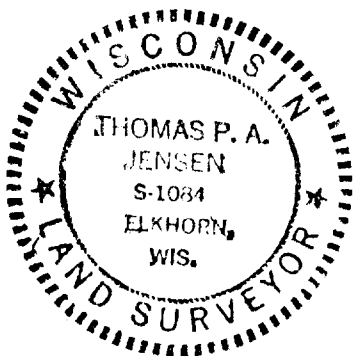

I, THOMAS P. A. JENSEN, WIS. REGISTERED LAND SURVEYOR,
DO HEREBY CERTIFY THAT THIS SURVEY WAS PERFORMED BY ME,
OR UNDER MY DIRECTION, IN FULL COMPLIANCE WITH THE OWNERS/
AGENTS INSTRUCTIONS AND CHAPTER AE-5 OF WISC. ADMIN. CODE
"MINIMUM STANDARDS FOR PROPERTY SURVEYS" AND THAT THIS MAP
IS AN ACCURATE REPRESENTATION THEREOF TO THE BEST OF MY
KNOWLEDGE AND BELIEF.

Thomas P. A. Jensen
THOMAS P. A. JENSEN S-1084

ZCL-00010

1985.067 7-801-J