
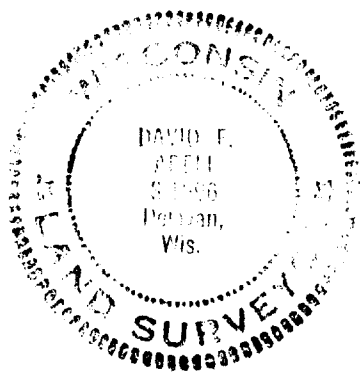
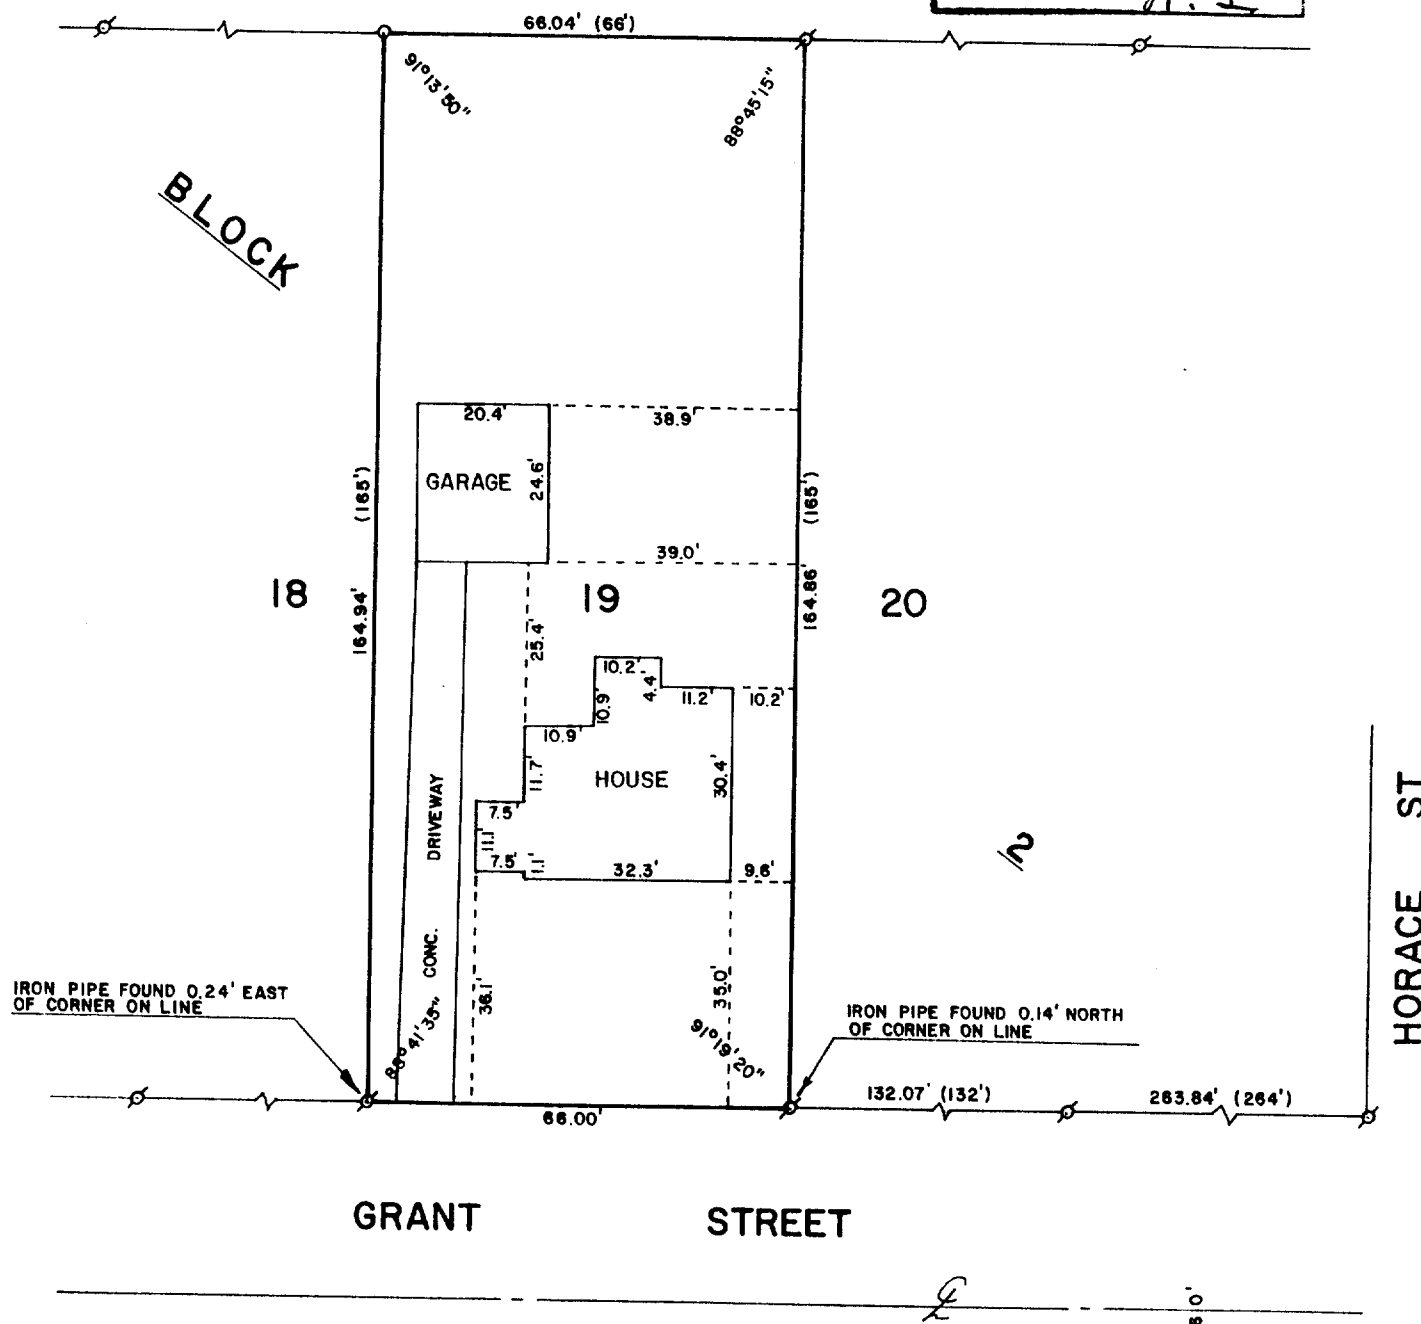


ABELL
SURVEYING & MAPPING
DELAVER, WISCONSIN 53115

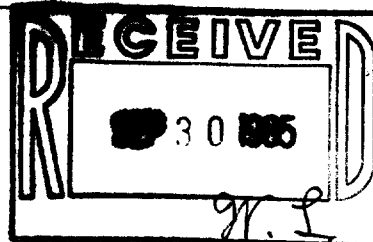

PLAT OF SURVEY OF

LOT 19, BLOCK 2, OF WHEELERS ADDITION TO THE CITY
OF LAKE GENEVA, WALWORTH COUNTY, WISCONSIN.

ORDERED BY: STURG TAGGART AGENCY
736 MAIN STREET
LAKE GENEVA, WI 53147



SCALE - 1"=30'

LEGEND

- x - IRON PIPE FOUND
- o - IRON ROD SET
- () - RECORDED AS

I, DAVID F. ABELL, DO HEREBY CERTIFY
THAT I HAVE SURVEYED THE PROPERTY
HEREON DESCRIBED ACCORDING TO THE
OFFICIAL RECORDS, AND THAT THE PLAT
HEREON IS A CORRECT REPRESENTATION
OF THE LOT LINES TO THE BEST OF MY
KNOWLEDGE AND BELIEF.

David F. Abell
DAVID F. ABELL
WISCONSIN REGISTERED LAND SURVEYOR, S-1596

DATE *Sept. 19, 1985*
JOB NUMBER - 0985002

7-805✓