



WALWORTH COUNTY
SURVEYING & MAPPING
LAKE GENEVA, WISCONSIN

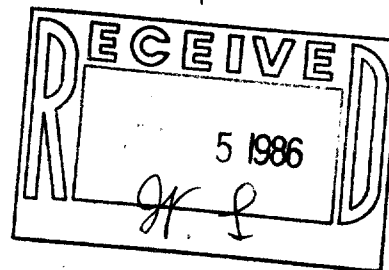

PLAT OF SURVEY OF

THE SOUTH 1/3 OF LOTS 1, 2 AND 3, BLOCK
12 OF THE ORIGINAL PLAT OF THE CITY OF
LAKE GENEVA, WALWORTH COUNTY, WISCONSIN.

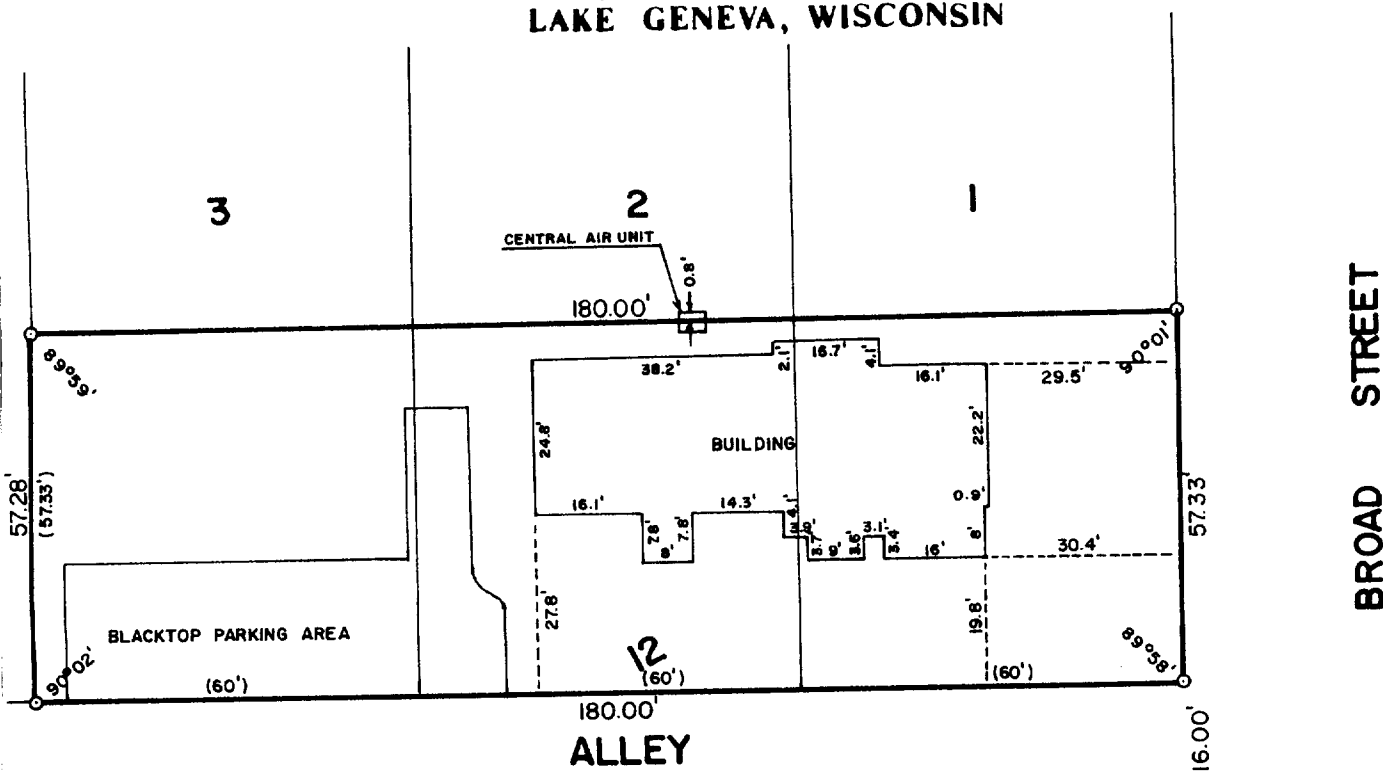

ORDERED BY: CENTURY 21
152 CENTER STREET
LAKE GENEVA, WISCONSIN
53147

I, ROBERT M. BAERENWALD, DO HEREBY CERTIFY THAT I
HAVE SURVEYED THE PROPERTY HEREON DESCRIBED ACCORDING
TO THE OFFICIAL RECORDS AND THAT THE PLAT HEREON IS A
CORRECT REPRESENTATION OF THE PROPERTY LINES TO THE
BEST OF MY KNOWLEDGE AND BELIEF.

Robert M. Baerenwald
ROBERT M. BAERENWALD
WISCONSIN REGISTERED LAND SURVEYOR, S-1508

Sept. 23, 1985
DATE JOB NO. 0381





SCALE: 1"=30'

⌘-IRON PIPE FOUND
○-IRON ROD SET
()-RECORDED AS


7-806-B

WALWORTH COUNTY
SURVEYING & MAPPING
LAKE GENEVA, WISCONSIN

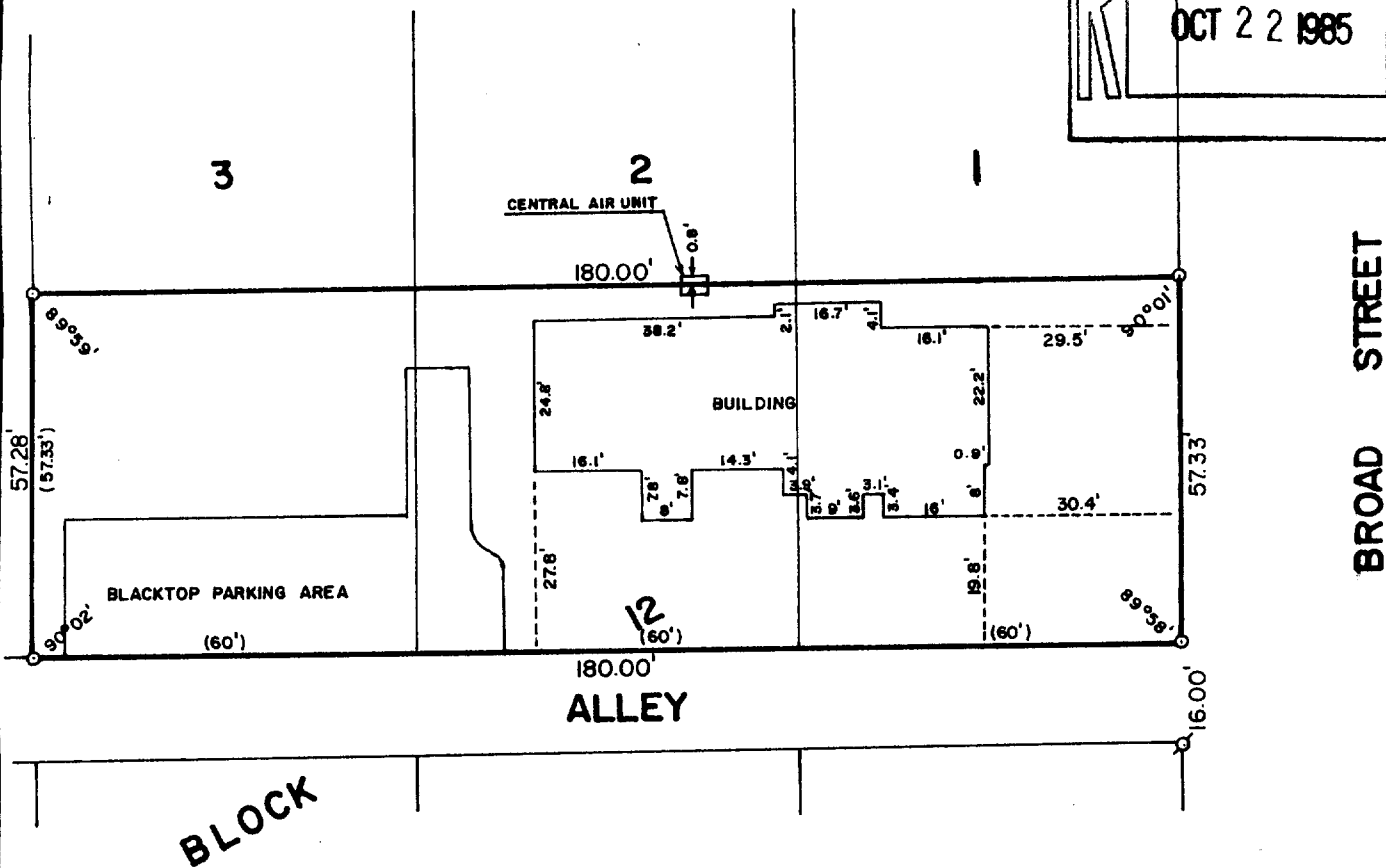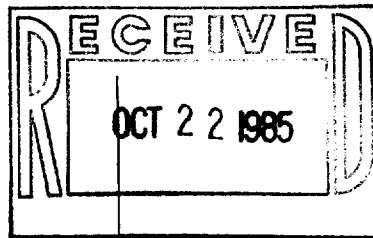

PLAT OF SURVEY OF

THE SOUTH 1/3 OF LOTS 1, 2 AND 3, BLOCK
12 OF THE ORIGINAL PLAT OF THE CITY OF
LAKE GENEVA, WALWORTH COUNTY, WISCONSIN.

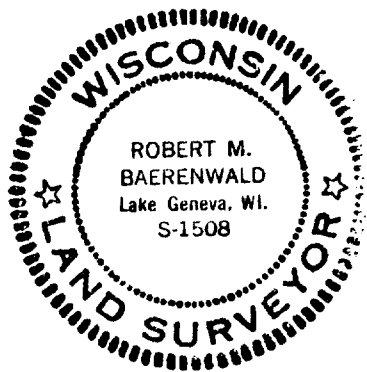

ORDERED BY: CENTURY 21
152 CENTER STREET
LAKE GENEVA, WISCONSIN
53147

I, ROBERT M. BAERENWALD, DO HEREBY CERTIFY THAT I
HAVE SURVEYED THE PROPERTY HEREON DESCRIBED ACCORDING
TO THE OFFICIAL RECORDS AND THAT THE PLAT HEREON IS A
CORRECT REPRESENTATION OF THE PROPERTY LINES TO THE
BEST OF MY KNOWLEDGE AND BELIEF.

Robert M. Baerenwald
ROBERT M. BAERENWALD
WISCONSIN REGISTERED LAND SURVEYOR, S-1508

Sept. 23, 1985
DATE JOB NO. 0381



SCALE: 1"=30'

Ø-IRON PIPE FOUND
○-IRON ROD SET
()-RECORDED AS

7-806-B