

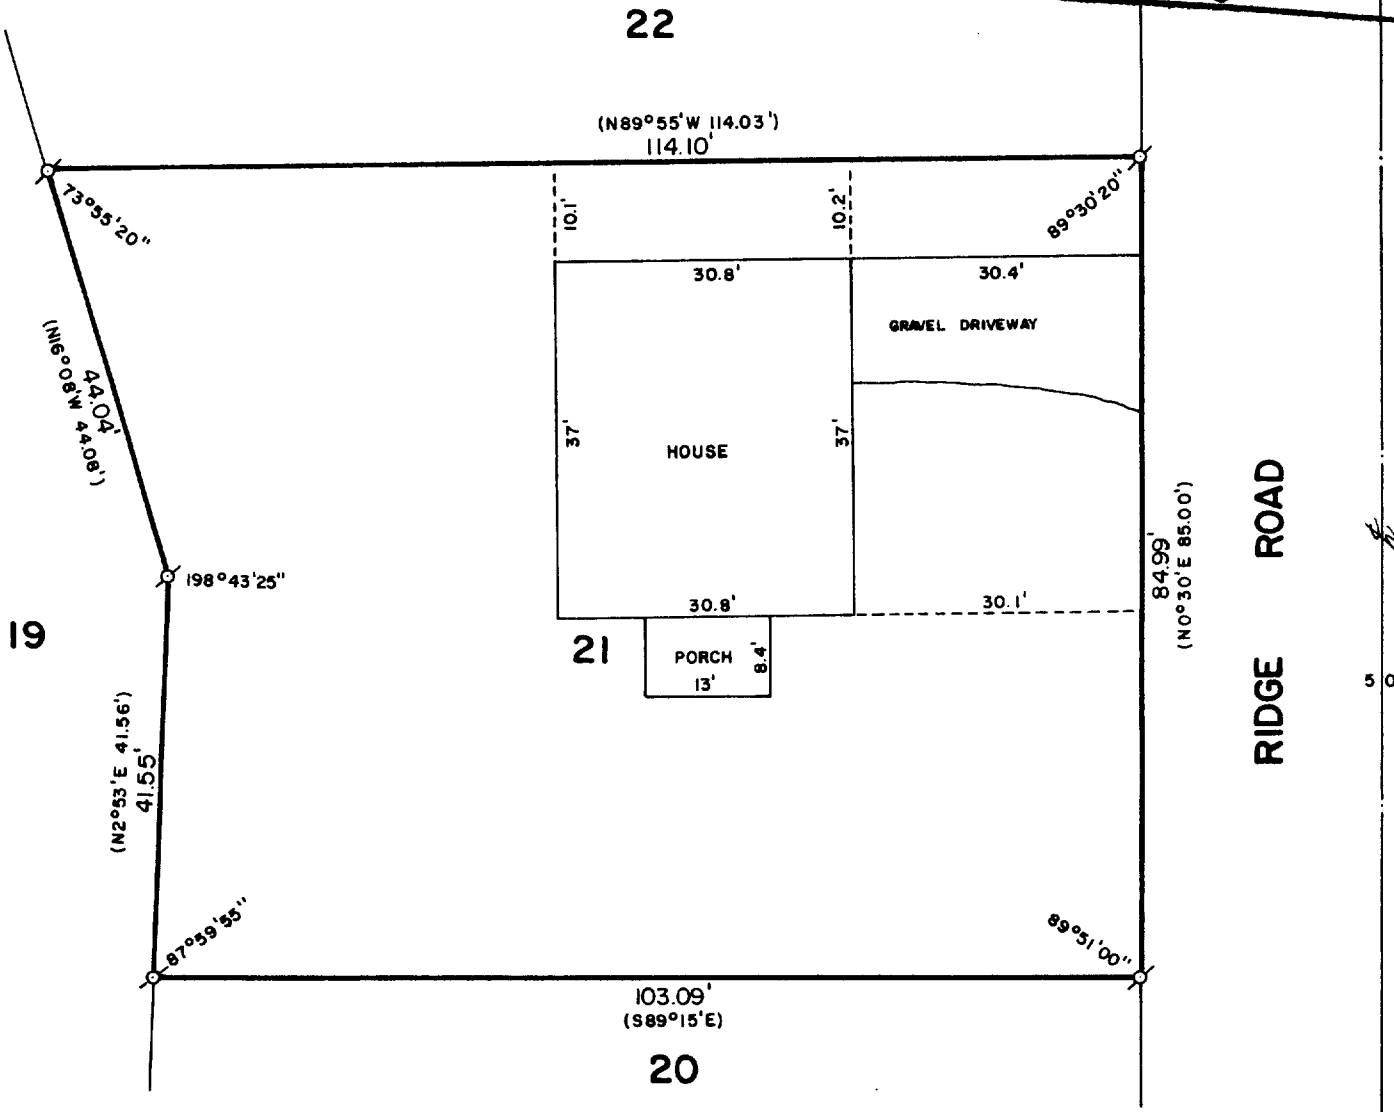


WALWORTH COUNTY
SURVEYING & MAPPING
LAKE GENEVA, WISCONSIN

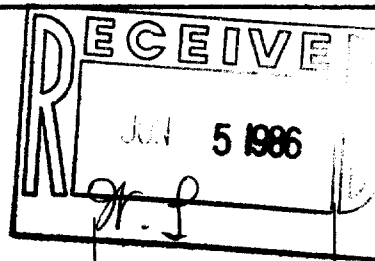

PLAT OF SURVEY OF

LOT 21 OF STURWOOD ADDITION TO THE CITY
OF LAKE GENEVA, WALWORTH COUNTY, WISCONSIN.

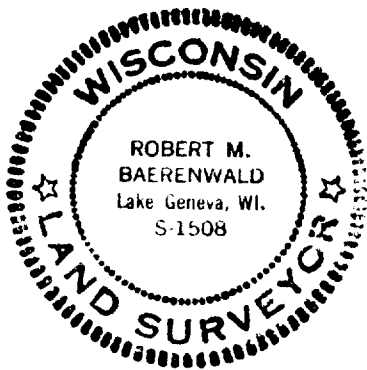

ORDERED BY: MILDRED KILAVOS
P. O. BOX 3424
OAK PARK, ILLINOIS 60303



SCALE: 1"=20'

⊘ - IRON PIPE FOUND
() - RECORDED AS

I, ROBERT M. BAERENWALD, DO HEREBY CERTIFY THAT I
HAVE SURVEYED THE PROPERTY HEREON DESCRIBED ACCORDING
TO THE OFFICIAL RECORDS AND THAT THE PLAT HEREON IS A
CORRECT REPRESENTATION OF THE PROPERTY LINES TO THE
BEST OF MY KNOWLEDGE AND BELIEF.

Robert M. Baerenwald
ROBERT M. BAERENWALD
WISCONSIN REGISTERED LAND SURVEYOR, S-1508

April 24, 1986
DATE JOB NO. 0523

25T 00020

7-821-B ✓