


RECEIVED
AUG 6 1986
H. L.


DODGE STREET

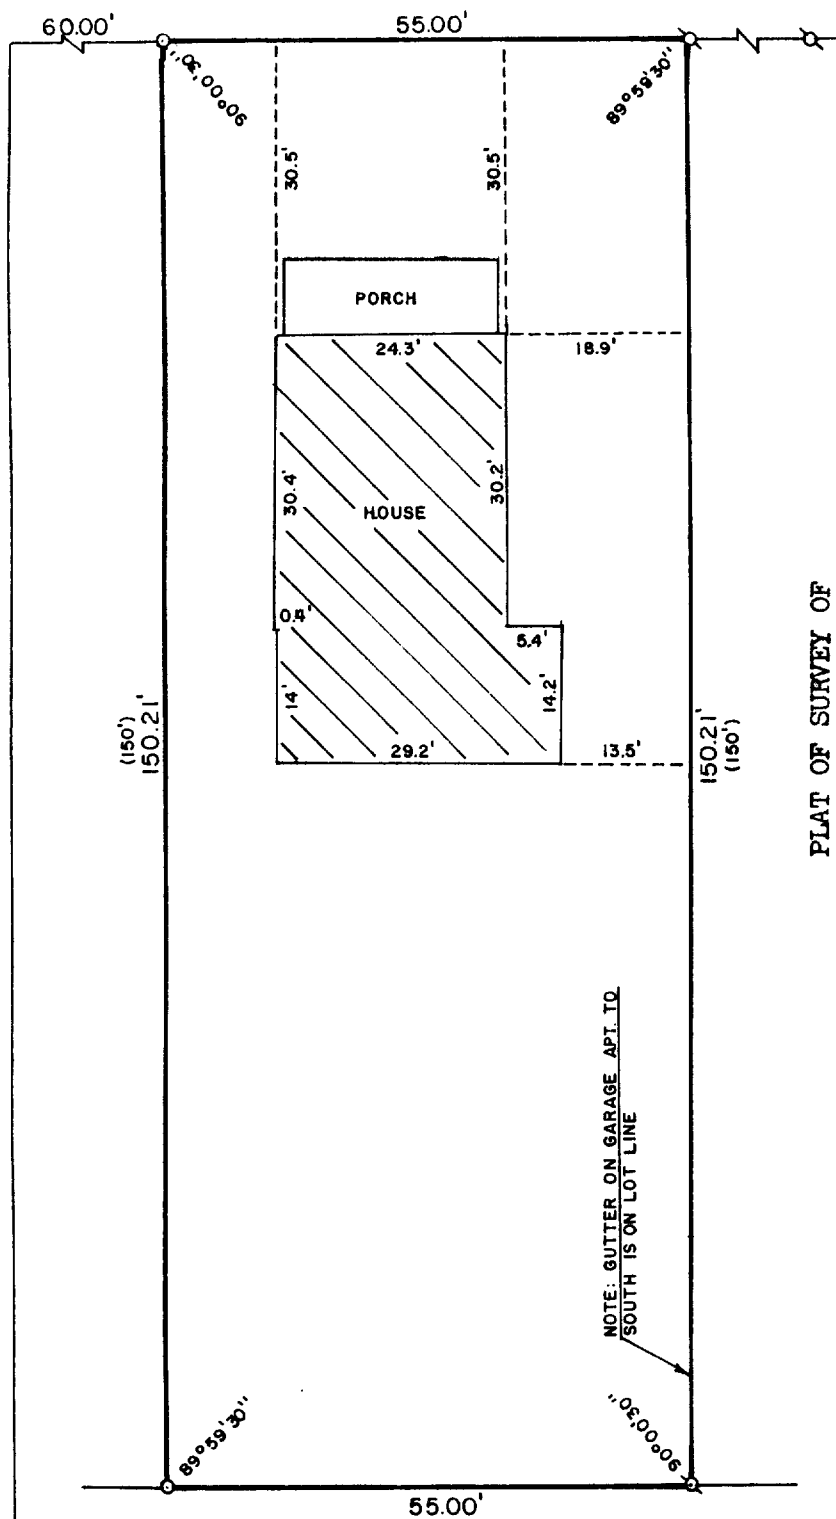

PLAT OF SURVEY OF

A PARCEL OF LAND RECORDED AND DESCRIBED AS FOLLOWS: COMMENCING SIXTY (60) FEET SOUTH FROM THE SW CORNER OF ELMWOOD AVENUE AND DODGE STREET, IN THE CITY OF LAKE GENEVA, WALWORTH COUNTY, WISCONSIN, FORMERLY VILLAGE OF GENEVA), ACCORDING TO THE RECORDED PLAT OF SAID VILLAGE OF RECORD IN THE OFFICE OF THE REGISTER OF DEEDS IN AND FOR WALWORTH COUNTY, WISCONSIN; RUNNING THENCE SOUTH ON ELMWOOD AVENUE FIFTY-FIVE (55) FEET; THENCE WEST, ONE HUNDRED FIFTY (150) FEET; THENCE NORTH FIFTY-FIVE (55) FEET; THENCE EAST, ONE HUNDRED FIFTY (150) FEET TO THE PLACE OF BEGINNING.

ORDERED BY: COLDWELL BANKER
GENEVA LAKES AREA REALTORS
838 MAIN STREET
LAKE GENEVA, WISCONSIN 53147

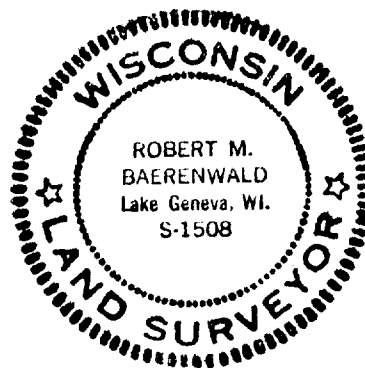

I, ROBERT M. BAERENWALD, DO HEREBY CERTIFY THAT I HAVE SURVEYED THE PROPERTY HEREON DESCRIBED ACCORDING TO THE OFFICIAL RECORDS AND THAT THE PLAT HEREON IS A CORRECT REPRESENTATION OF THE PROPERTY LINES TO THE BEST OF MY KNOWLEDGE AND BELIEF.

Robert M. Baerenwald
ROBERT M. BAERENWALD
WISCONSIN REGISTERED LAND SURVEYOR, S-1508

DATE _____

JOB NO. 0669

7-837^v

SCALE: 1"=20'

♂ - IRON PIPE FOUND
 ○ - IRON ROD PLACED
 () - RECORDED AS