


PLAT OF SURVEY

OF

LOTS 9 & 12, AND THE SOUTH 25.00' OF THE EAST 83.00' OF LOT 10, AND THE EAST 83.00' OF LOT 11, ALL IN BLOCK 37 OF THE ORIGINAL PLAT OF THE VILLAGE (NOW CITY) OF LAKE GENEVA, WALWORTH COUNTY, WISCONSIN.

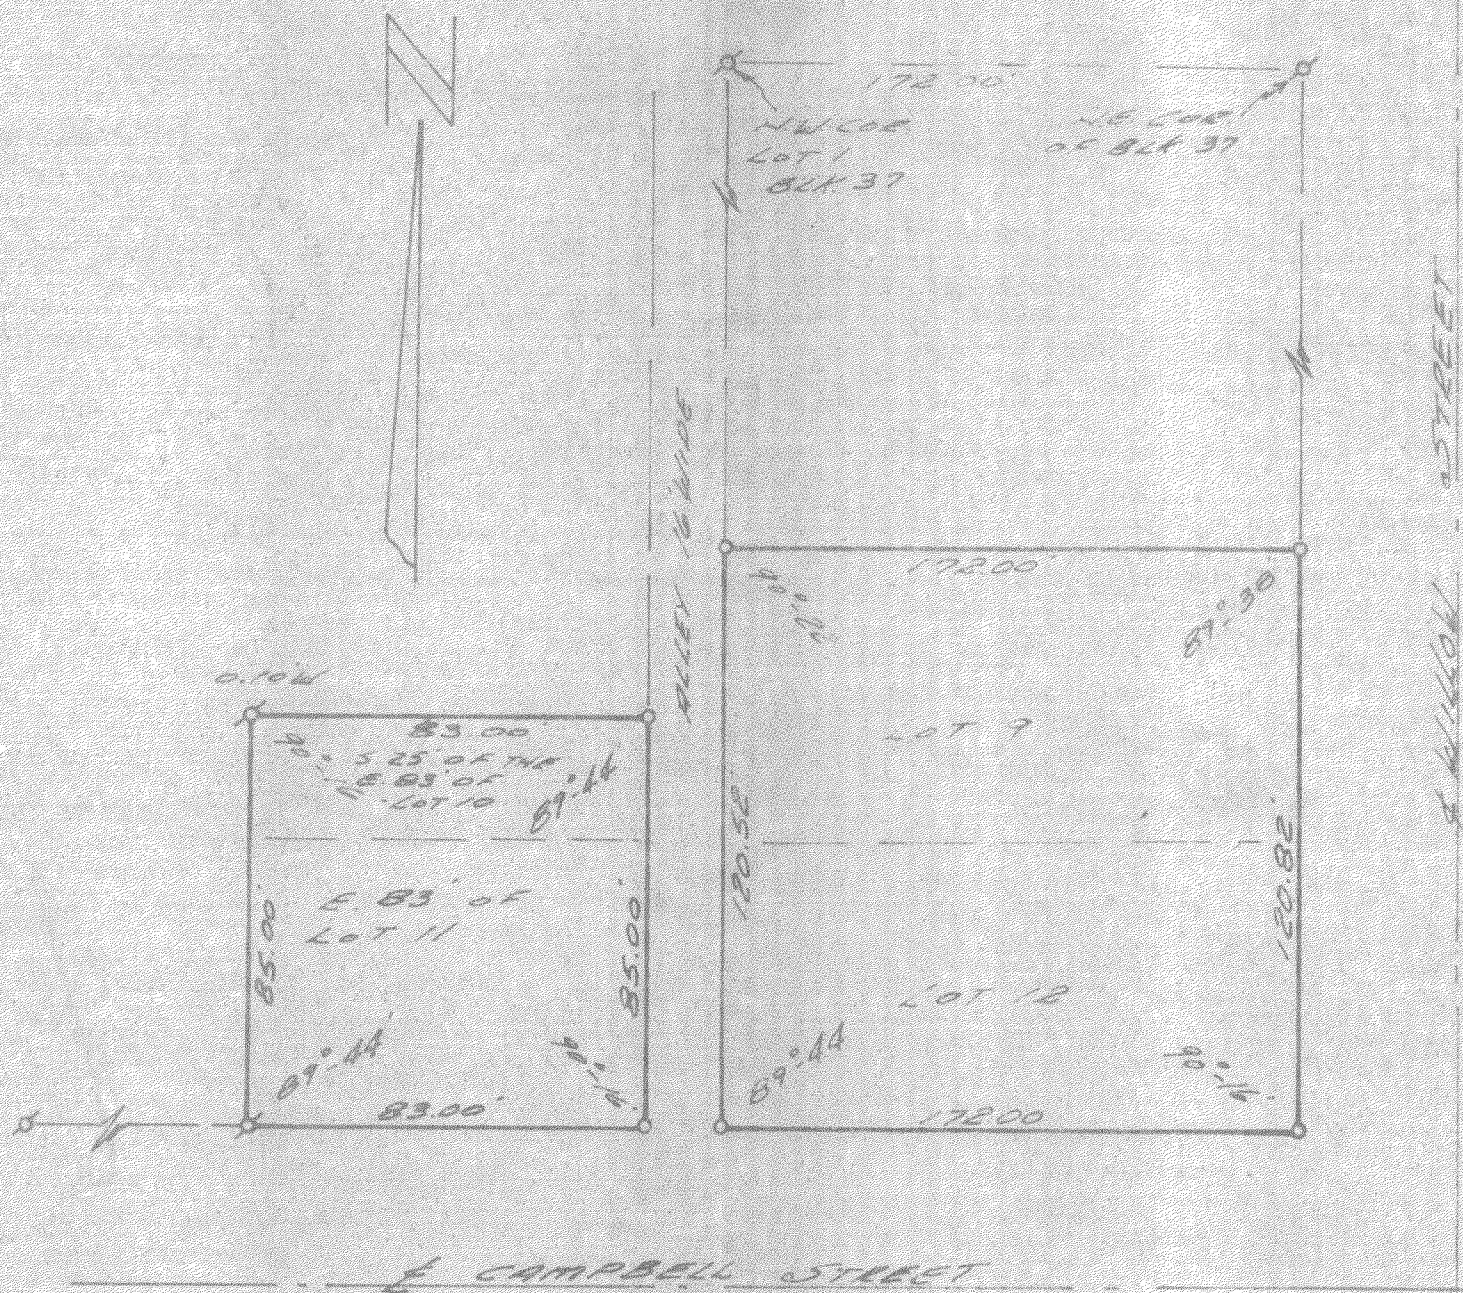

SURVEY AND PLAT BY

JENSEN & JOHNSON, INC.

CIVIL ENGINEERS AND SURVEYORS

Elkhorn, Wisconsin

LEGEND

- — Iron Pipe SET
- — Concrete Monument

Scale 1" = 40'

β — IRON PIPE FOUND

WE CERTIFY: That we have surveyed the above described property and that the plat shown hereon is an accurate survey and a true representation thereof and correctly shows the exterior boundary lines and all divisions of said property.

Date SEPT 1912

LLOYD L. JENSEN,

Wisconsin Registered Land Surveyor, No. S-211