


DUNHAM & RASMUSSEN
SURVEYING & ENGINEERING
DELAVER, WISCONSIN

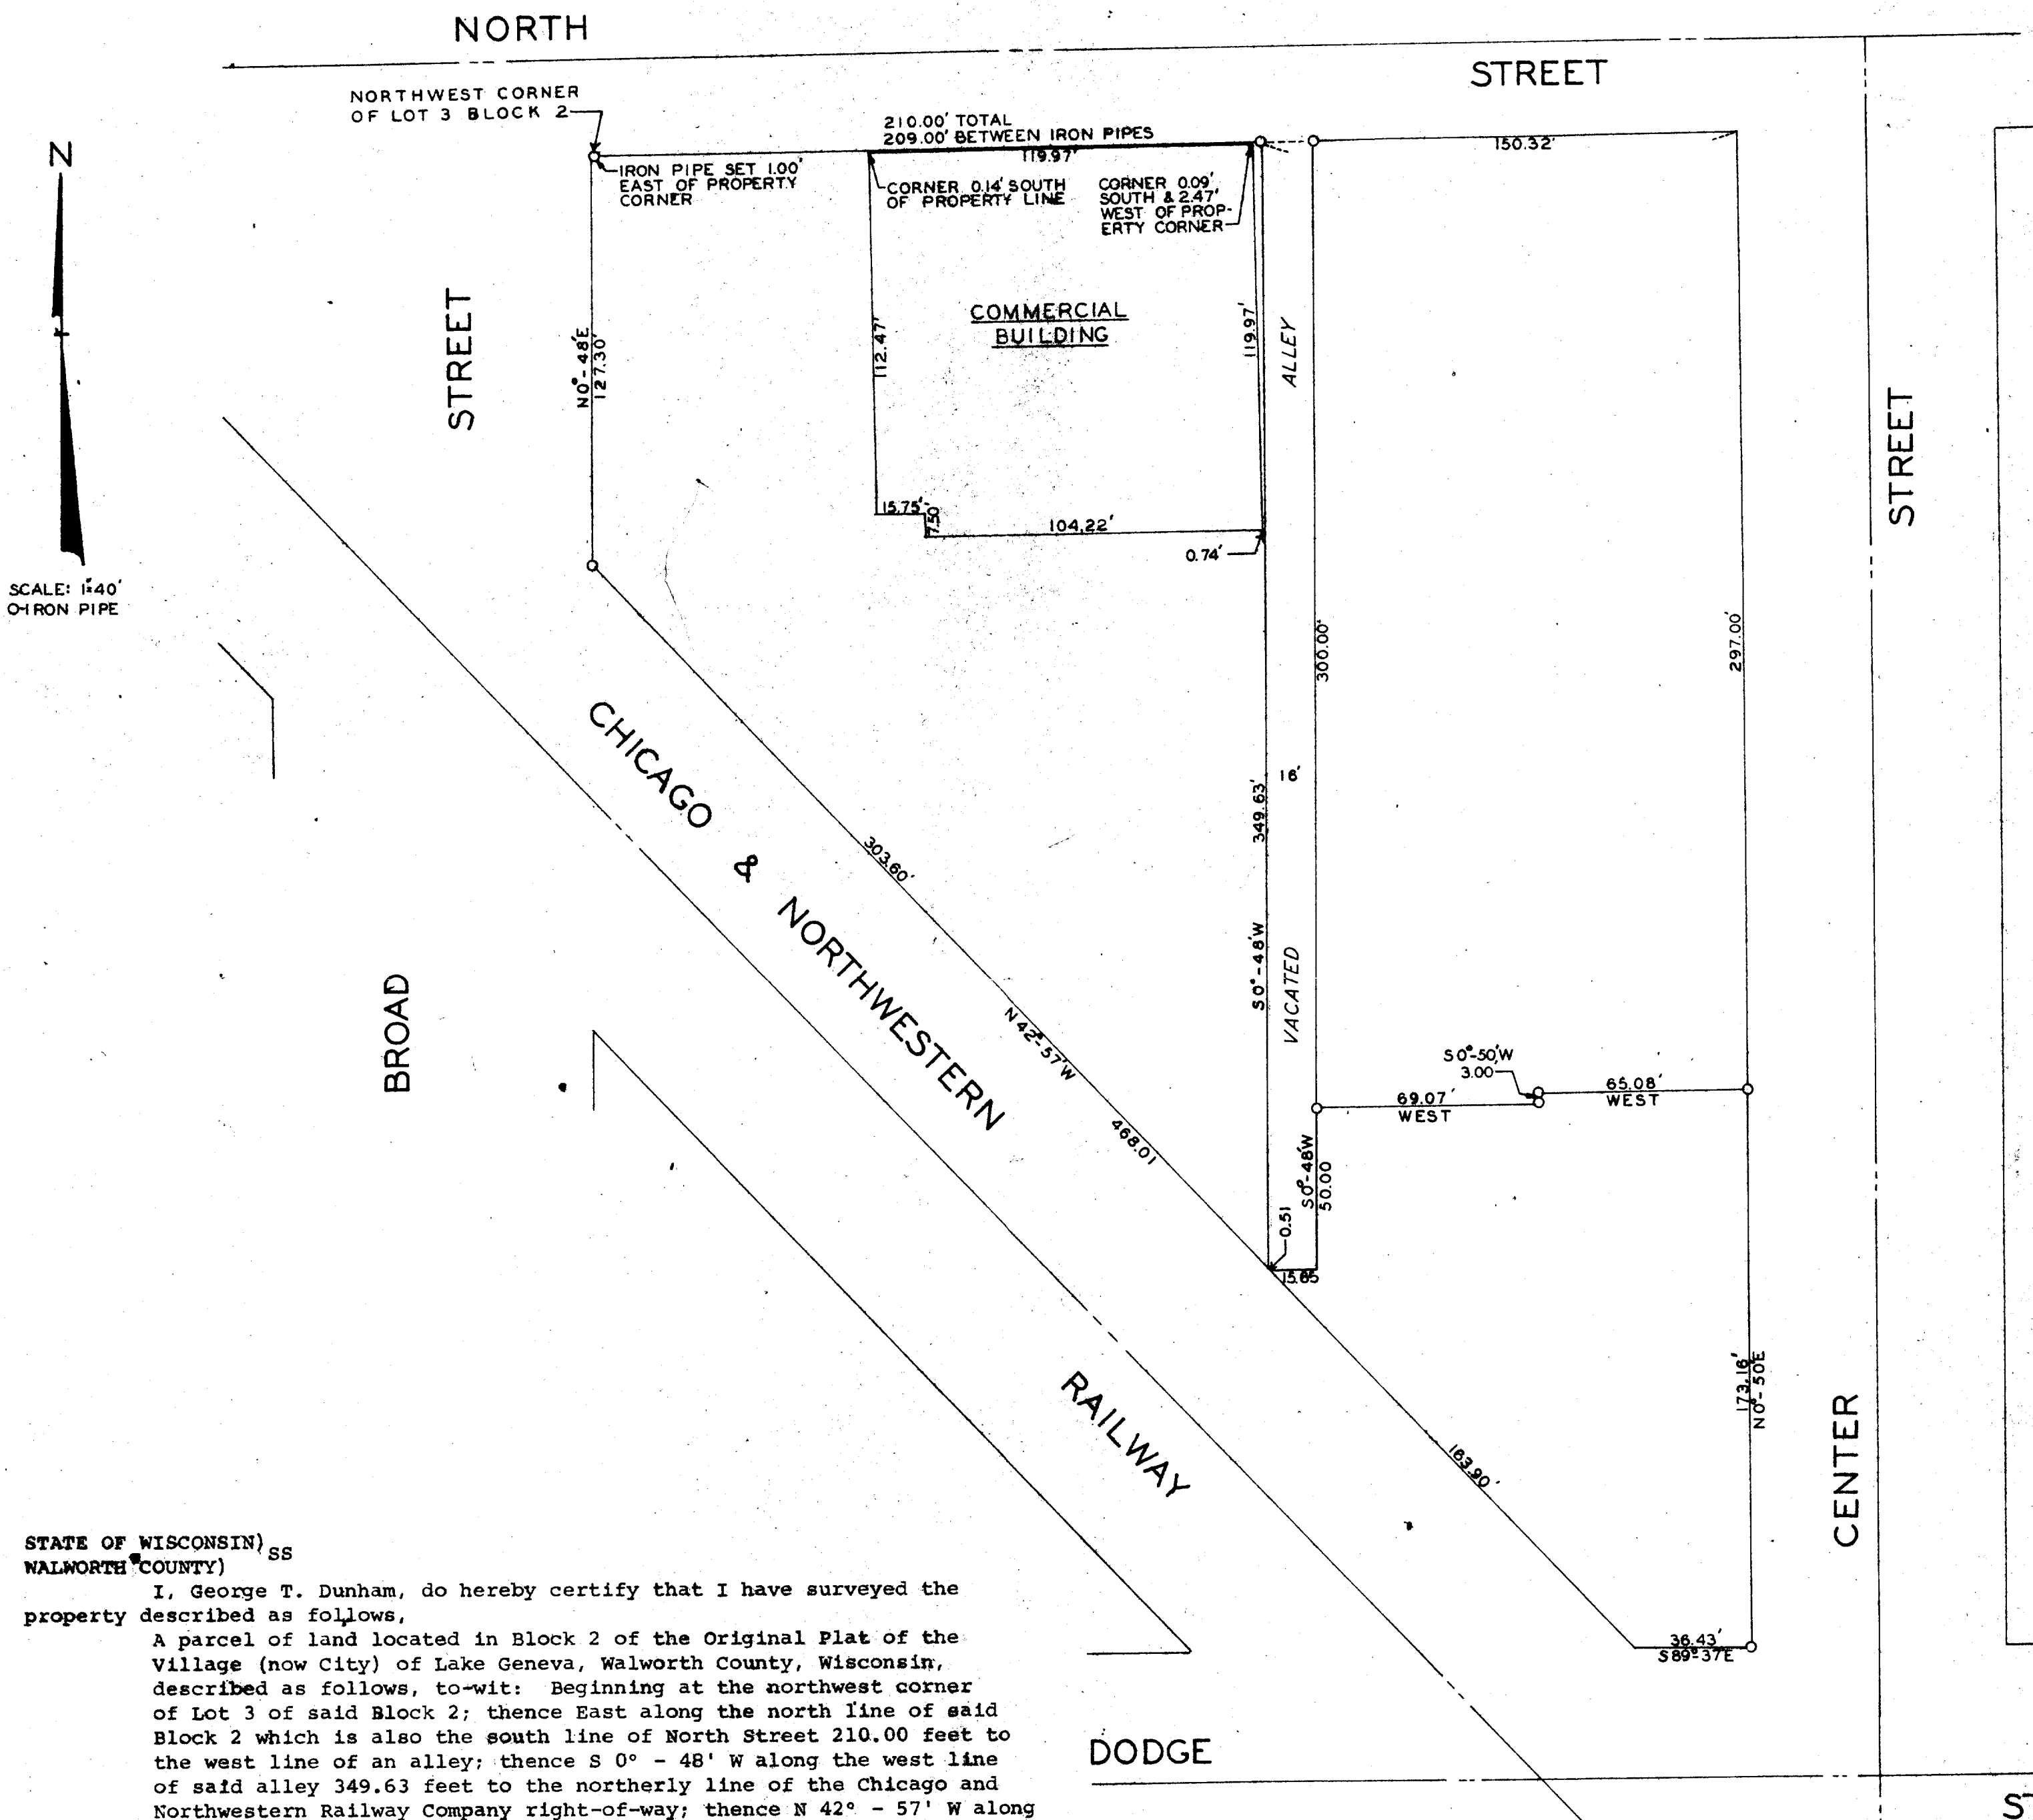

STATE OF WISCONSIN) ss
WALWORTH COUNTY)

I, George T. Dunham, do hereby certify that I have surveyed the property described as follows,
A parcel of land located in Block 2 of the Original Plat of the Village (now City) of Lake Geneva, Walworth County, Wisconsin, described as follows, to-wit: Beginning at the northwest corner of Lot 3 of said Block 2; thence East along the north line of said Block 2 which is also the south line of North Street 210.00 feet to the west line of an alley; thence S 0° - 48' W along the west line of said alley 349.63 feet to the northerly line of the Chicago and Northwestern Railway Company right-of-way; thence N 42° - 57' W along the northerly line of said railroad right-of-way 303.60 feet to the east line of Broad Street; thence N 0° - 48' E along the east line of Broad Street 127.30 feet to the place of beginning.
ALSO beginning at a point on the east line of said Block 2 located 297.00 feet south of the south line of North Street; thence West parallel with the south line of North Street 65.08 feet; thence S 0° - 50' W parallel with the east line of said Block 2, 3.00 feet; thence West parallel with the south line of North Street 69.07 feet to the east line of an alley; thence S 0° - 48' W along the east line of said alley 50.00 feet; thence West parallel with the north line of said Block 2, 15.65 feet to the northerly line of the Chicago & Northwestern Railway Company right-of-way; thence S 42° - 57' E along the northerly line of said railway right-of-way 163.90 feet to the north line of Dodge Street; thence S 89° - 37' E along the north line of Dodge Street 36.43 feet to the east line of said Block 2; thence N 0° - 50' E along said east line 173.16 feet to the place of beginning.

and that the plat shown above is a correct representation of the property lines and of the improvements located thereon
September 1960
Revised Feb. 15, 1961

George T. Dunham
George T. Dunham, Wisconsin Land Surveyor No. S-306