



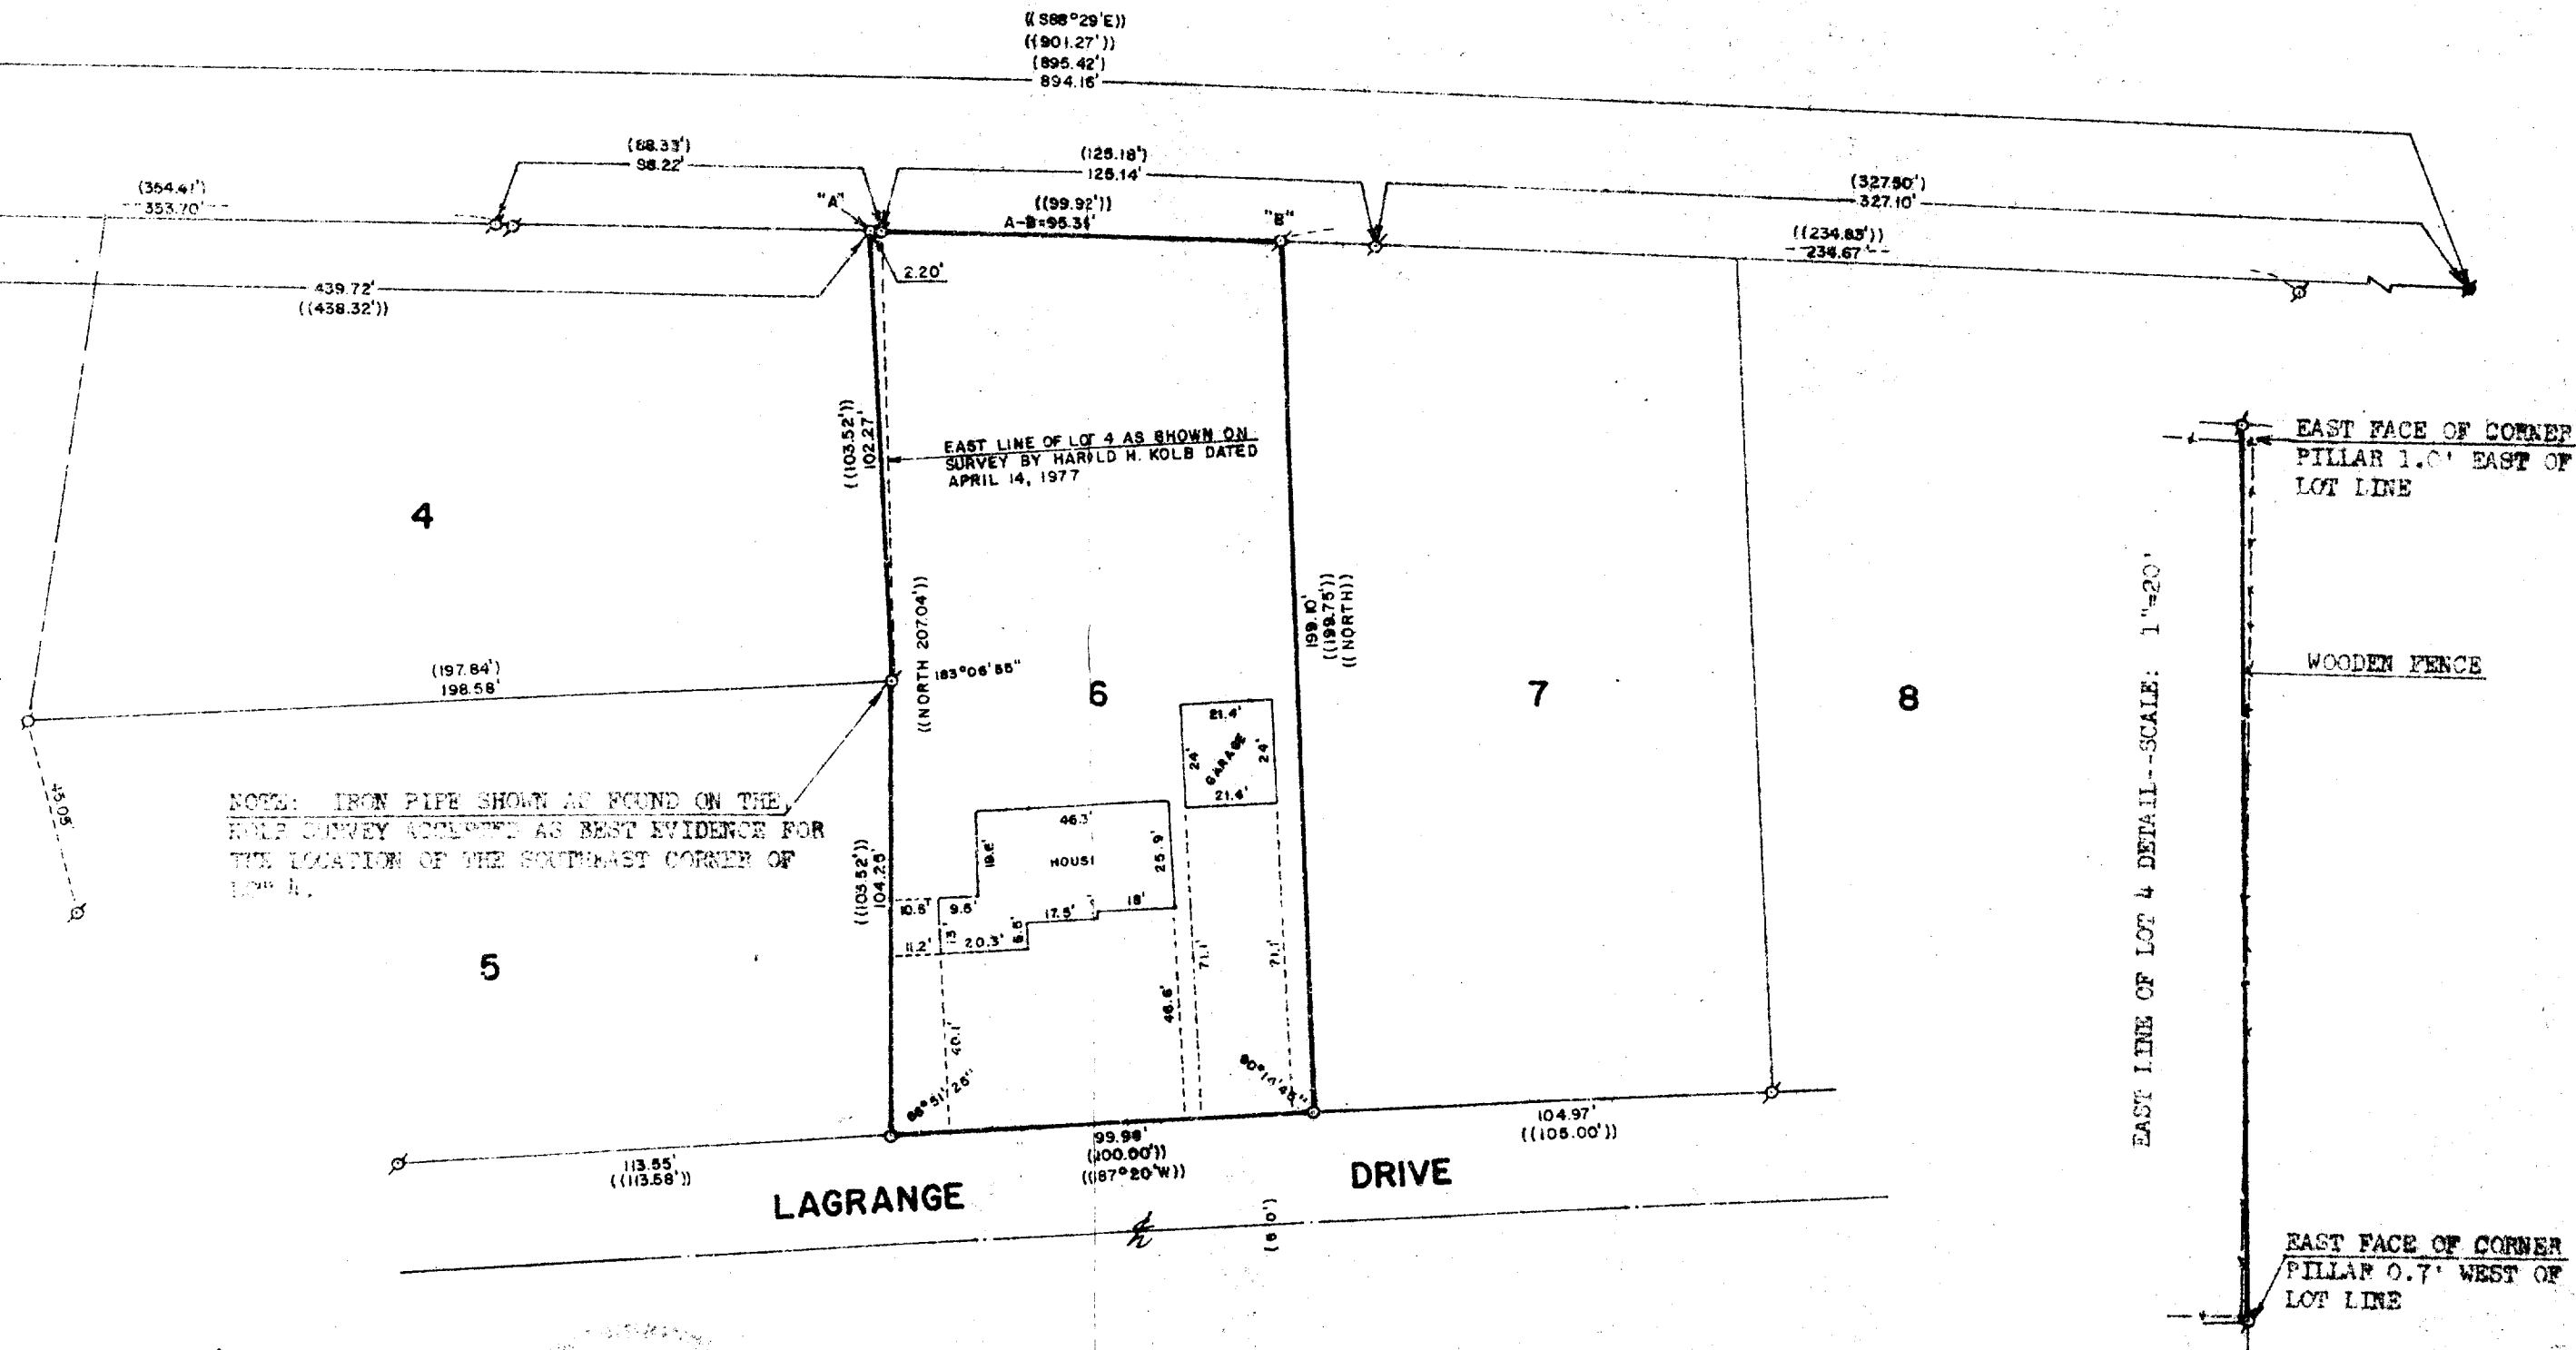

SCALE: 1"=40'

- o - IRON PIPE FOUND
- - CONCRETE MONUMENT FOUND
- o - IRON ROD PLACED
- (()) - RECORD DIMENSION AS SHOWN ON PLAT OF LAKE GENEVA GENEVA EAST SHORE ESTATES BY JOSEPH M. BIACI, 1958
- () - RECORD DIMENSION AS SHOWN ON PLAT OF SURVEY BY LLOYD I. JENSEN, DATED OCTOBER 30, 1954

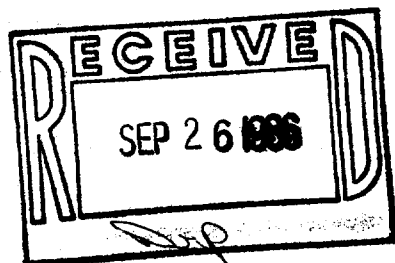

PLAT OF SURVEY OF

LOT 6 OF LAKE GENEVA EAST SHORE ESTATES SUBDIVISION, LOCATED IN SECTION 1, T 1 N, R 17 E, CITY OF LAKE GENEVA, WALWORTH COUNTY, WISCONSIN.

ORDERED BY: KENOSHA SAVINGS & LOAN
410 BROAD STREET
LAKE GENEVA, WISCONSIN 53147

I, ROBERT M. BAERENWALD, DO HEREBY CERTIFY THAT I HAVE SURVEYED THE PROPERTY HEREON DESCRIBED ACCORDING TO THE OFFICIAL RECORDS AND THAT THE PLAT HEREON IS A CORRECT REPRESENTATION OF THE PROPERTY LINES TO THE BEST OF MY KNOWLEDGE AND BELIEF.

Robert M. Baerenwald
ROBERT M. BAERENWALD
WISCONSIN REGISTERED LAND SURVEYOR, S-1508

DATE *July 22, 1986* JOB NO. 0656