
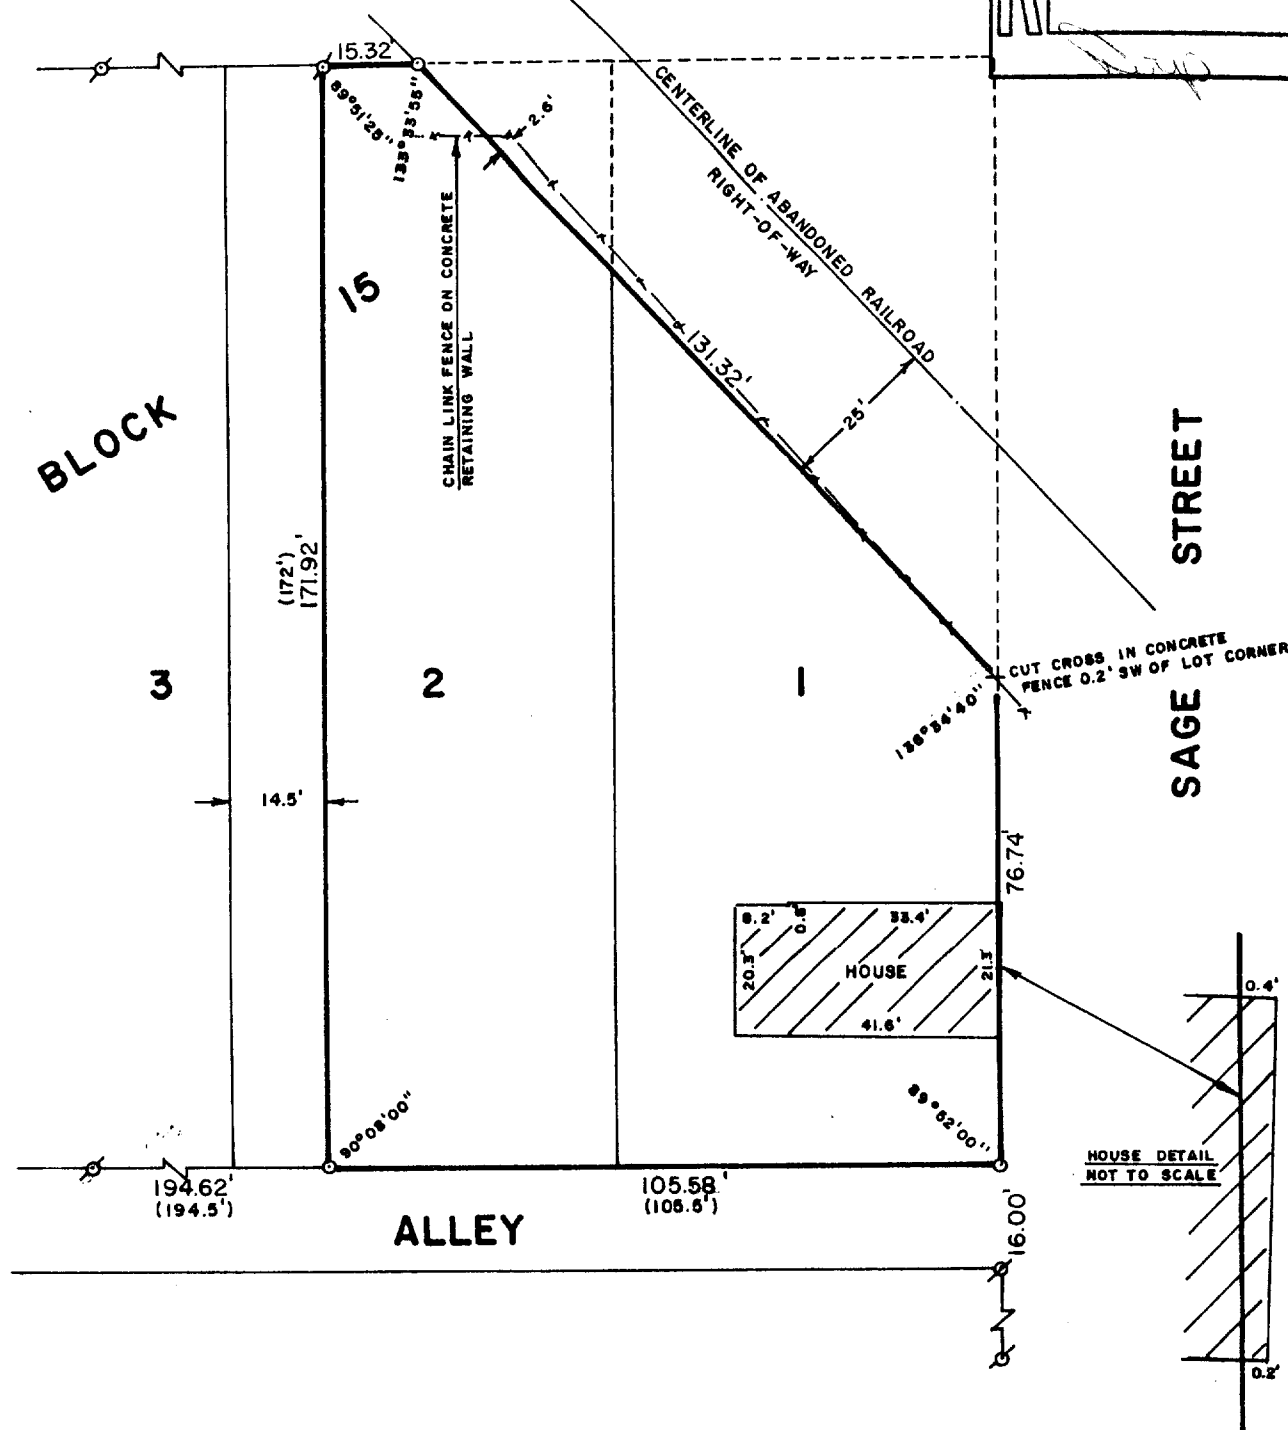


WISCONSIN STREET

WALWORTH COUNTY
SURVEYING & MAPPING
LAKE GENEVA, WISCONSIN

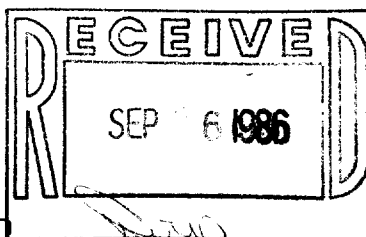

PLAT OF SURVEY OF

LOTS ONE (1) AND TWO (2), BLOCK FIFTEEN OF VILLAGE, NOW CITY, OF LAKE GENEVA, EXCEPT AS MUCH OF SAID LOTS AS WAS HERETOFORE CONVEYED AND IS NOW OCCUPIED AS THE RIGHT OF WAY OF THE CHICAGO AND NORTHWESTERN RAILWAY COMPANY, ALSO EXCEPTING FOURTEEN AND FIVE-TENTHS (14.5') FEET OFF THE WEST SIDE OF SAID LOT TWO (2).

ORDERED BY: REALTY WORLD-TAGGART
736 MAIN STREET
LAKE GENEVA, WISCONSIN 53147



SCALE: 1"=30'

⊘ - IRON PIPE FOUND
○ - IRON ROD PLACED
() - RECORDED AS

I, ROBERT M. BAERENWALD, DO HEREBY CERTIFY THAT I HAVE SURVEYED THE PROPERTY HEREON DESCRIBED ACCORDING TO THE OFFICIAL RECORDS AND THAT THE PLAT HEREON IS A CORRECT REPRESENTATION OF THE PROPERTY LINES TO THE BEST OF MY KNOWLEDGE AND BELIEF.

Robert M. Baerenwald
ROBERT M. BAERENWALD
WISCONSIN REGISTERED LAND SURVEYOR, S-1508

DATE *Aug. 29, 1986* JOB NO. 0722