


of
Lot 5, Block 15 of Geneva Lake Manufacturing Co. Addition
to the City of Lake Geneva, Walworth County, Wisconsin.

Surveyed by: Jensen Surveying & Mapping S.C.
45 S. Wisconsin P.O. Box 322
Elkhorn, WI. 53121

Note: This survey plat is not certified unless signed and sealed in red ink.


LEGEND

65,98

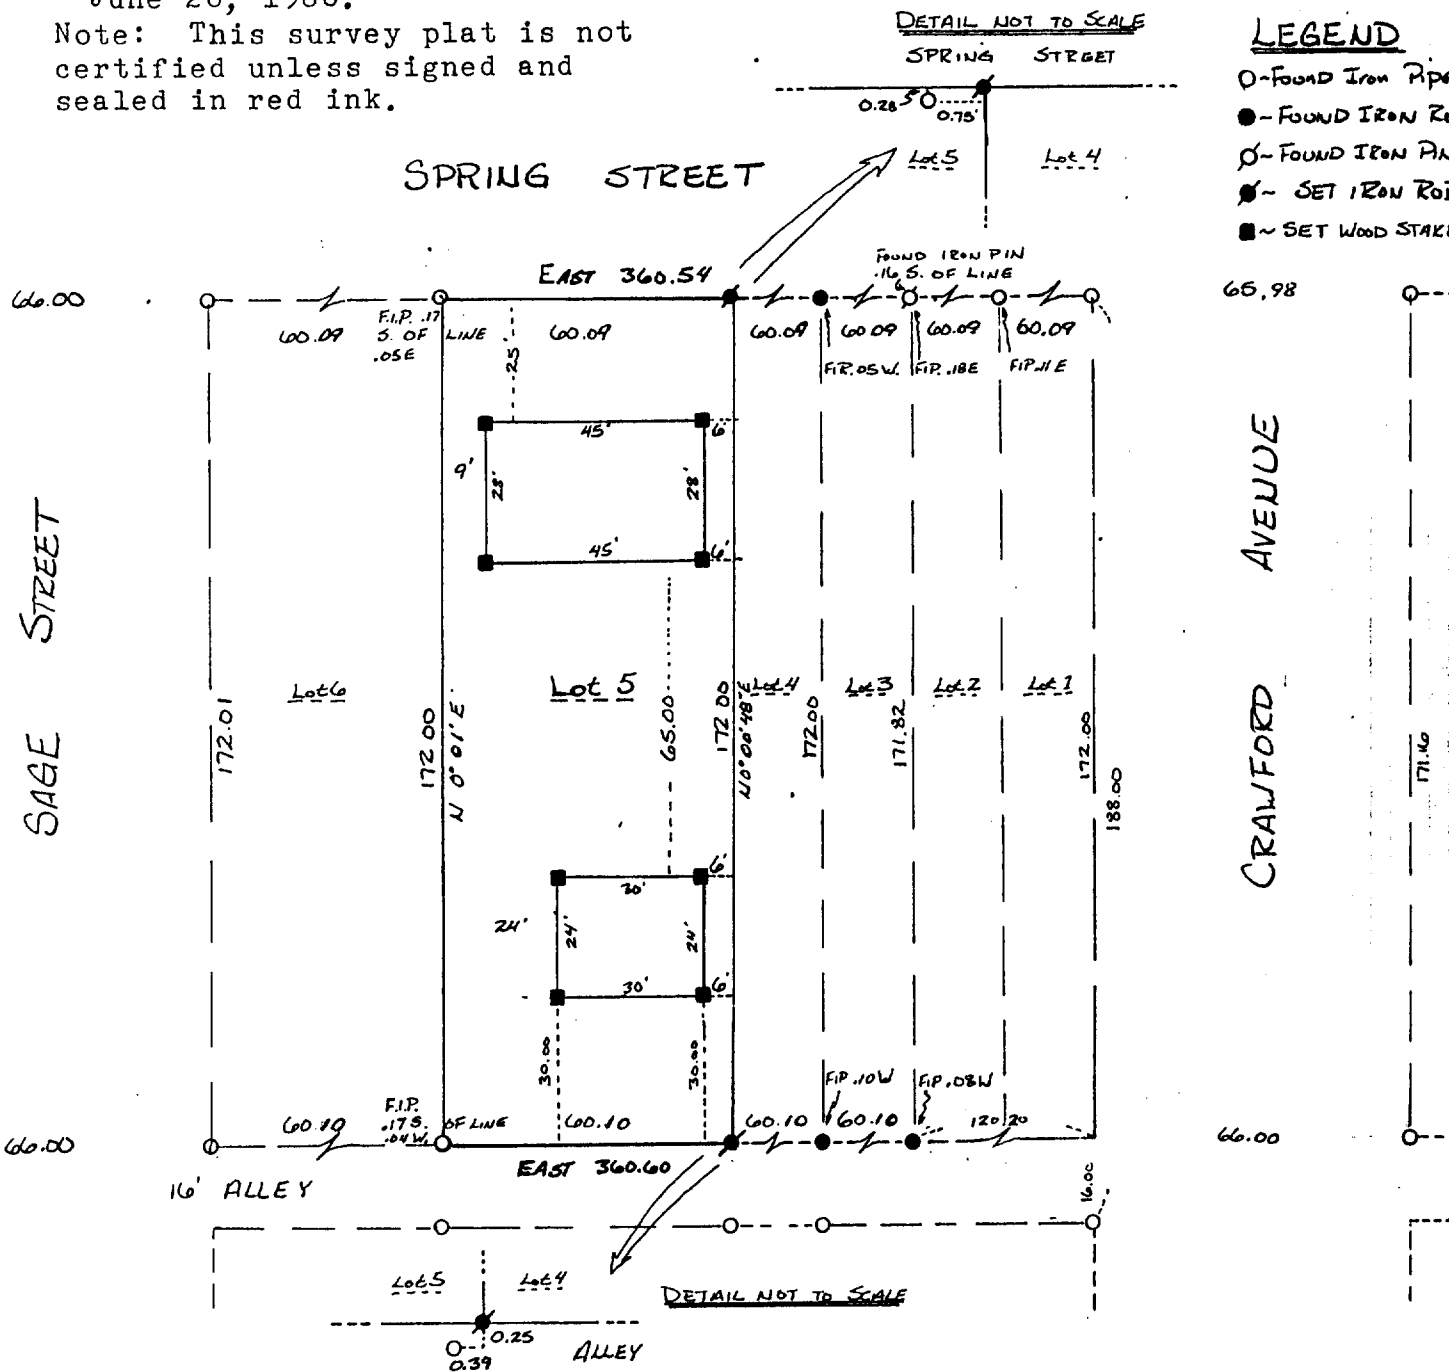

I, Thomas P.A. Jensen, Wisconsin Registered Land Surveyor, do hereby certify that this survey was performed by me, or under my direction, in full compliance with the owner's/agent's instructions and chapter A-E 5 of the Wisconsin Administrative Code "Minimum Standards For Property Surveys"; and that this map is an accurate representation thereof to the best of my knowledge and belief.

Thomas P.A. Jensen S-1084
Jensen Surveying & Mapping S.C.
45 S. Wisconsin St.
Elkhorn, Wisconsin. 53121
(414) 723-3434

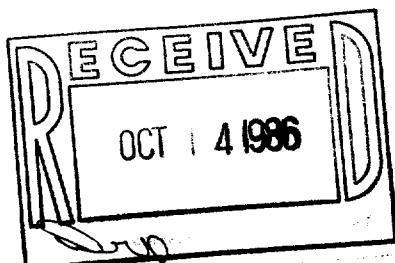

1986.058 X

7-869