
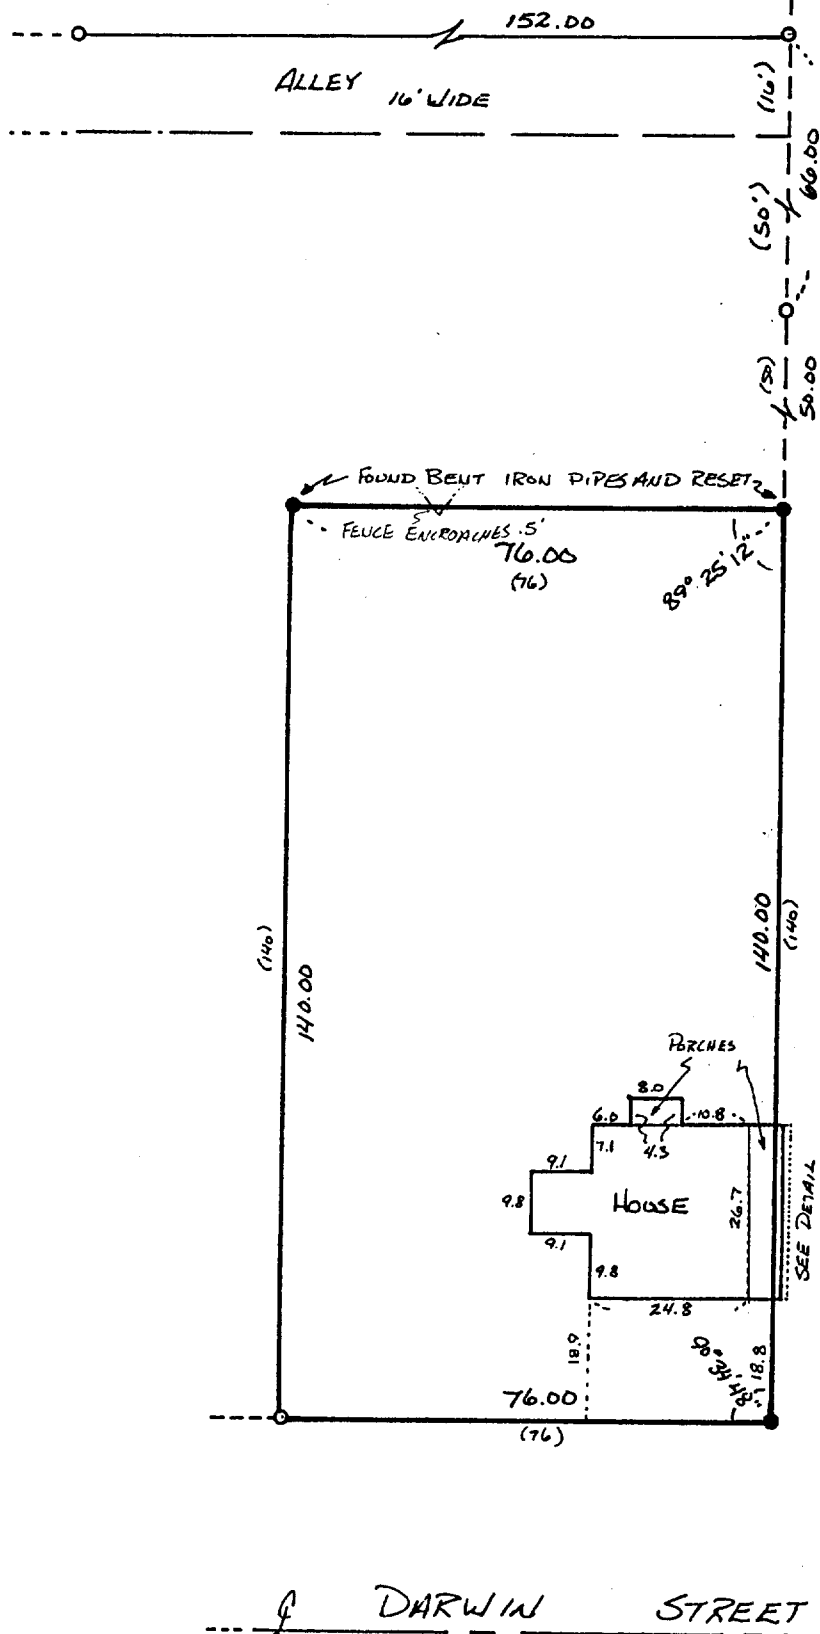


PLAT OF SURVEY

of
Lot 10, except the North 100.00 feet, of Block 2 of
E.D. Phillips Subdivision, City of Lake Geneva,
Walworth County, Wisconsin.

Surveyed for: Lynne Ulicki
730 Sienna Dr.
Schaumburg, IL. 60193

Jensen Surveying & Mapping S.C.
45 S. Wisconsin St. P.O. Box 322
Elkhorn, Wisconsin. 53121
(414) 723-3434

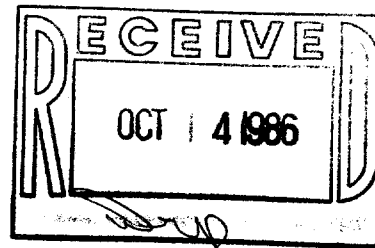

EAST STREET


DARWIN STREET

1" = 30'

LEGEND

- O - FOUND IRON PIPE
- - SET IRON PIPE

DETAIL (Not to Scale)

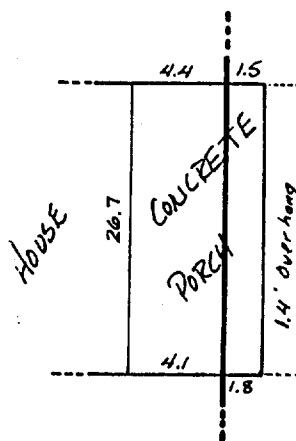

Note: This survey plat is
not certified unless signed
and sealed in red ink.

I, Thomas P.A. Jensen, Wisconsin Registered Land Surveyor,
do hereby certify that this survey was performed by me, or under
my direction, in full compliance with the owner's/agent's
instructions and chapter A-E 5 of the Wisconsin Administrative
Code "Minimum Standards For Property Surveys"; and that this map
is an accurate representation thereof to the best of my knowledge
and belief.

Thomas P.A. Jensen S-1084
Jensen Surveying & Mapping S.C.

1986.056 X

7-870