


KOLB LAND CONSULTING, INC.
LAND SURVEYING • SUBDIVIDING • LAND PLANNING


929 WILLIAMS STREET LAKE GENEVA, WISCONSIN 53147 414-248-3697

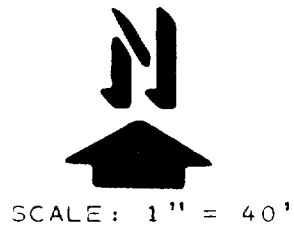

LEGEND

Ø - IRON PIPE FOUND
() - AS RECORDED

NOTE: ANGLES SHOWN ARE FROM
FIELD WORK.

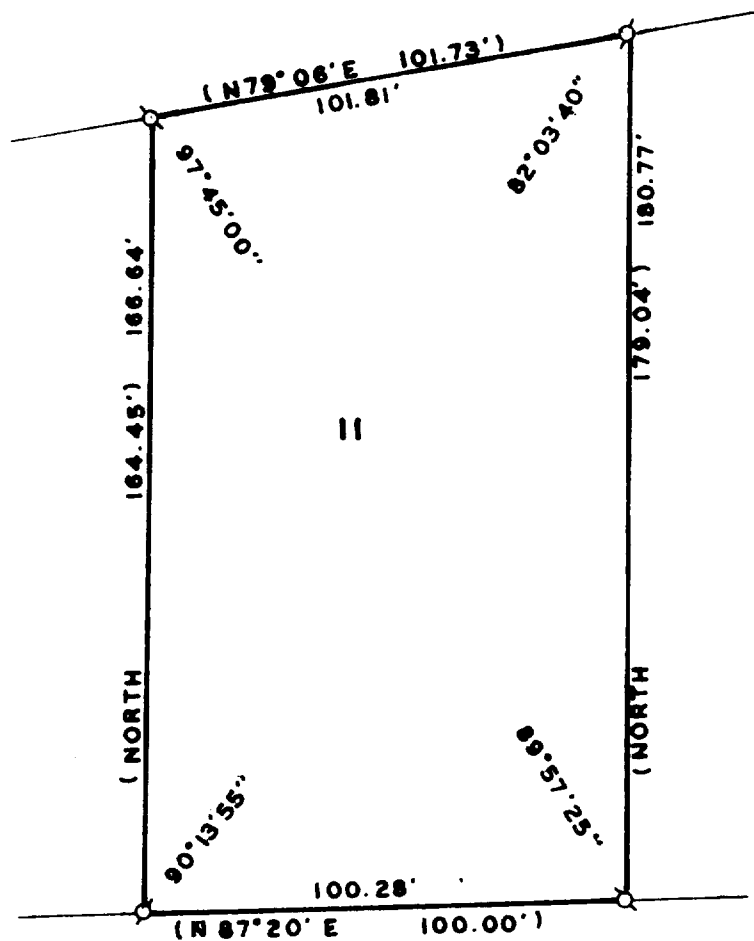

LAGRANGE DRIVE 50' WIDE

PLAT OF SURVEY OF

LOT 11 OF THE LAKE GENEVA EAST SHORE EST.,
CITY OF LAKE GENEVA, WALWORTH COUNTY, WIS-
CONSIN.

ORDERED BY: CENTURY 21
152 CENTER ST.
LAKE GENEVA, WI. 53147

I, HAROLD H. KOLB, DO HEREBY CERTIFY THAT
I HAVE SURVEYED THE PROPERTY HEREON DES-
CRIBED ACCORDING TO THE OFFICIAL RECORDS
AND THAT THE PLAT HEREON IS A CORRECT REP-
RESENTATION OF THE LOT LINES TO THE BEST
OF MY KNOWLEDGE AND BELIEF.

Harold H. Kolb

HAROLD H. KOLB

WISCONSIN REGISTERED LAND SURVEYOR, S-187

DATE MAY 7, 1986

REVISED

REVISED

