
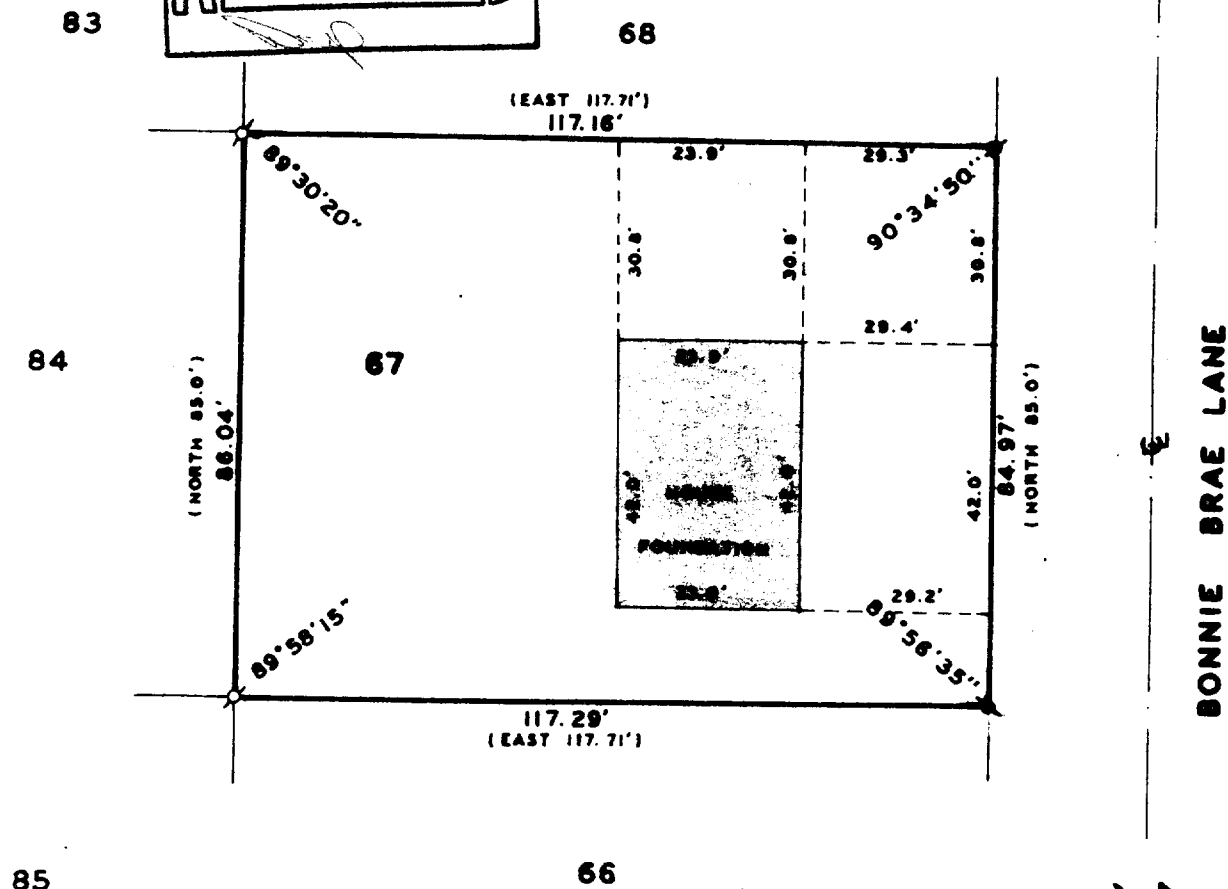


KOLB LAND CONSULTING, INC.
LAND SURVEYING • SUBDIVIDING • LAND PLANNING

929 WILLIAMS STREET LAKE GENEVA, WISCONSIN 53147 414-248-3697

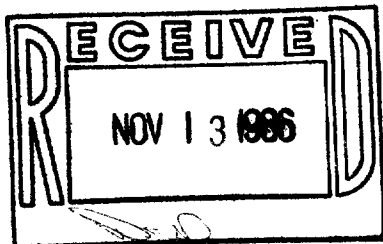

Ø - IRON PIPE FOUND
● - IRON ROD FOUND
() - AS RECORDED

ORDERED BY:
FIVE STAR HOMES
90 E. GENEVA SQUARE
LAKE GENEVA, WI. 53147

PLAT OF SURVEY

LOT 67 OF H.E. WELLS ADDITION TO THE
CITY OF LAKE GENEVA, WALWORTH COUNTY
WISCONSIN.

I, HAROLD H. KOLB, DO HEREBY CERTIFY THAT
I HAVE SURVEYED THE PROPERTY HEREON DES-
CRIBED ACCORDING TO THE OFFICIAL RECORDS
AND THAT THE PLAT HEREON IS A CORRECT REP-
RESENTATION OF THE LOT LINES AND THE PRIN-
CIPAL LINES OF THE FOUNDATION, TO THE BEST
OF MY KNOWLEDGE AND BELIEF.



Harold H. Kolb

HAROLD H. KOLB

WISCONSIN REGISTERED LAND SURVEYOR, S-187

DATE JULY 22, 1986

REVISED _____

REVISED _____