

PLAT OF SURVEY
OF

LOT 34, COLUMBIAN SUBDIVISION, LOCATED IN THE SOUTHEAST 1/4 OF SECTION 26, T. 2 N.,
R. 17 E. OF THE 4TH P.M., CITY OF LAKE GENEVA, WALWORTH COUNTY, WISCONSIN.

FOR: MILWAUKEE MORTGAGE CO
AND KEVIN AND MARY DAWSON

SCALE 1" = 30

o = IRON PIPE STAKE FOUND.



α = SPIKE FOUND.

We surveyed the above described property
and the map hereon is a true representation
hereof and shows the size and location of the
property, its extent, boundaries, the location
and dimensions of all visible structures thereon
fences, apparent easements and roadways and
visible encroachments of any.

This survey is made for the exclusive use of
the present owners of the property, and also
those who purchase, mortgage, or guarantee
the title thereto within one year from date
hereof.

Dated at Burlington, this 24th day
of DECEMBER, 1986

John F. Degen
John F. Degen, Land Surveyor S 242

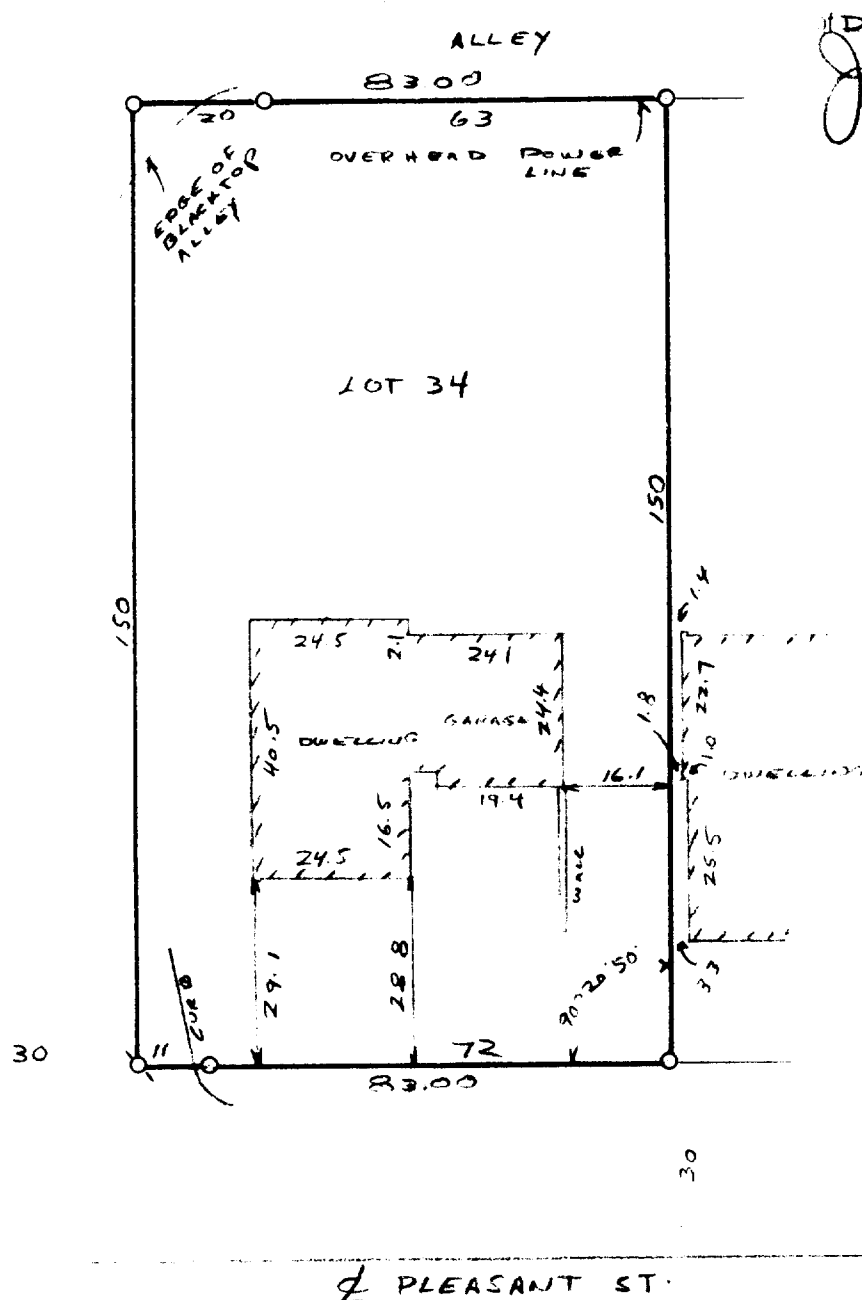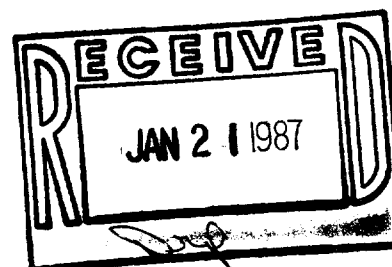

7-886

11-C-2 #65

2CL-31