


WALWORTH COUNTY
SURVEYING & MAPPING
LAKE GENEVA, WISCONSIN



PLAT OF SURVEY OF
LOT 9, BLOCK 25 OF THE ORIGINAL PLAT OF THE
VILLAGE OF GENEVA (NOW CITY OF LAKE GENEVA),
WALWORTH COUNTY, WISCONSIN.

ORDERED BY: MARILYN D'LUGOSZ
RT. 3, BOX 400
LAKE GENEVA, WISCONSIN 53147

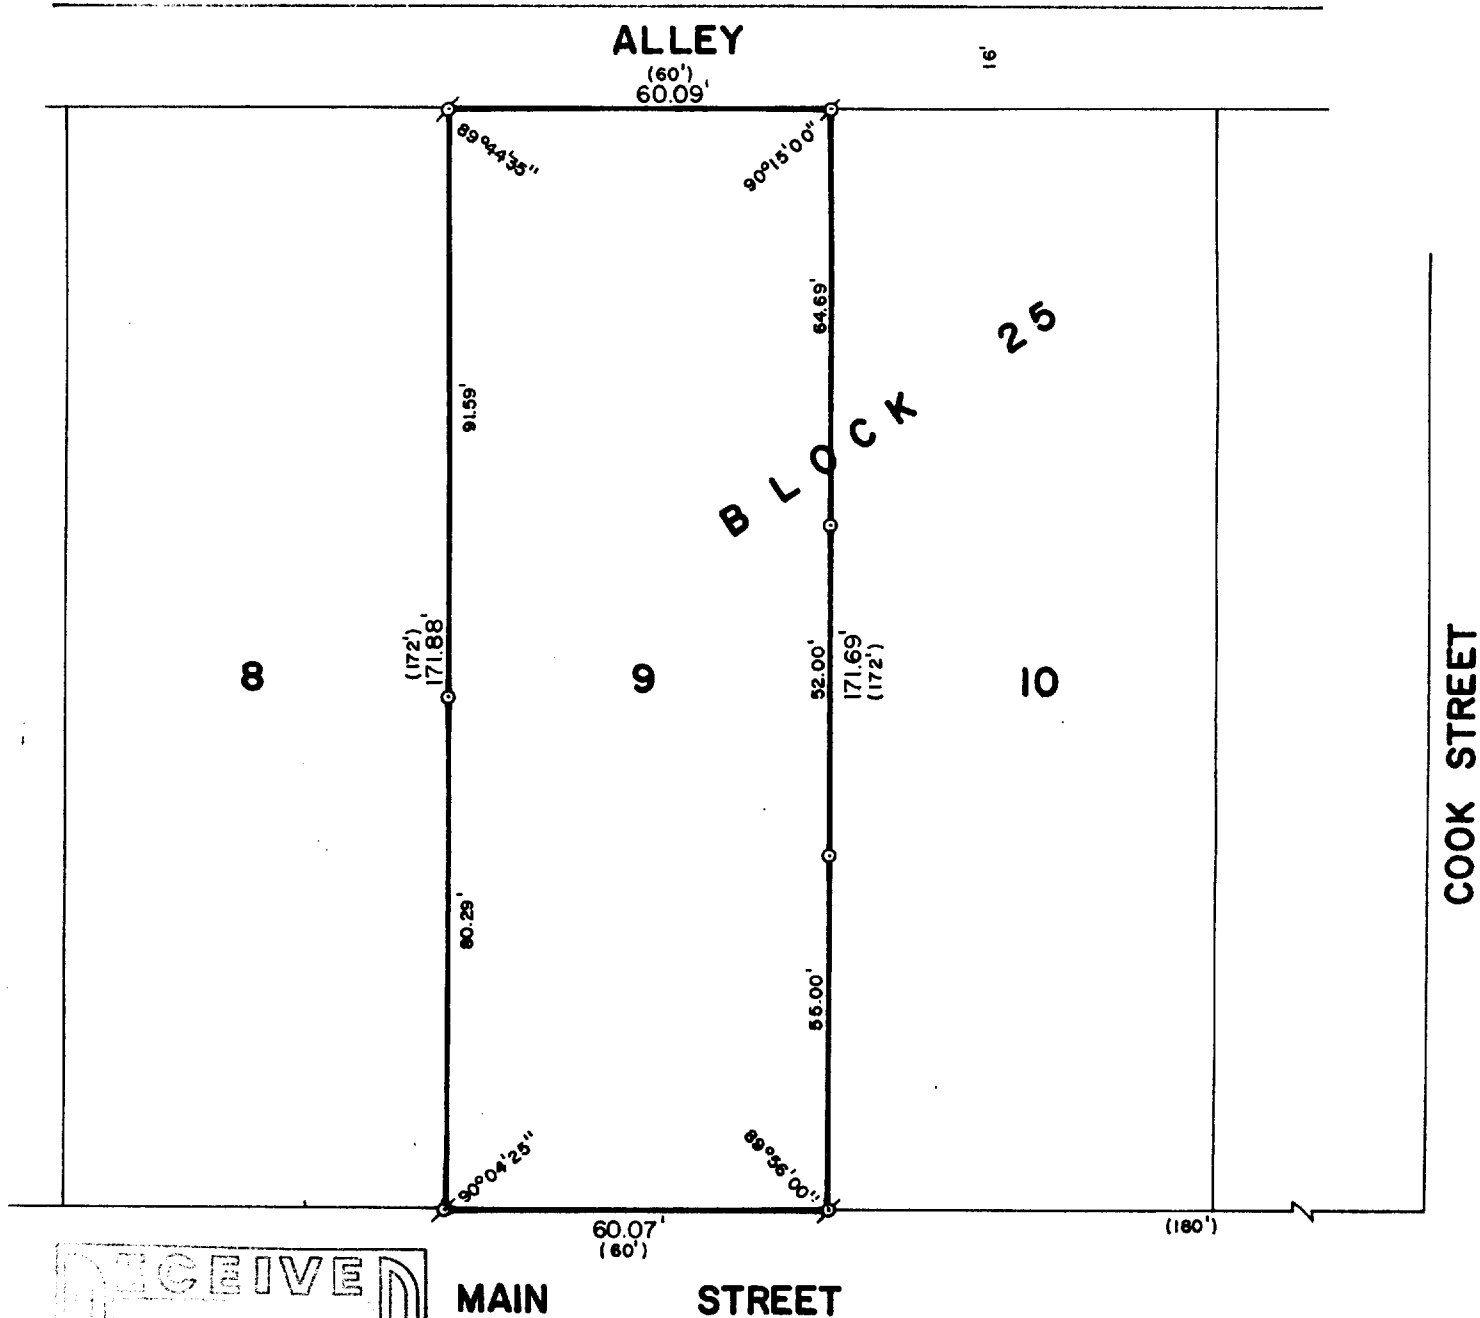

SCALE: 1"=30'

σ - IRON PIPE FOUND
○ - IRON ROD PLACED
() - RECORDED AS

I, ROBERT M. BAERENWALD, DO HEREBY CERTIFY THAT I
HAVE SURVEYED THE PROPERTY HEREON DESCRIBED ACCORDING
TO THE OFFICIAL RECORDS AND THAT THE PLAT HEREON IS A
CORRECT REPRESENTATION OF THE PROPERTY LINES TO THE
BEST OF MY KNOWLEDGE AND BELIEF.

Robert M. Baerenwald
ROBERT M. BAERENWALD
WISCONSIN REGISTERED LAND SURVEYOR, S-1508

DATE *Jun-27-1987*
JOB NO. 0672

NOTE: THIS IS NOT A CERTIFIED COPY UNLESS SEALED.