



D. D. COOPER & CO., INC.
Daniel D. Cooper
Rt. 4 Box 508B
Elkhorn, WI 53121

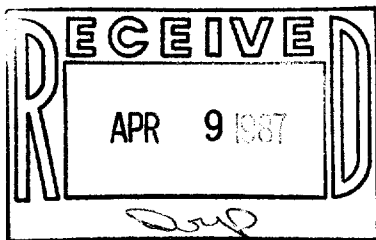


Plat of Survey of Lot 87 H.E. Wells Addition to the
City of Lake Geneva, Walworth County, Wisconsin

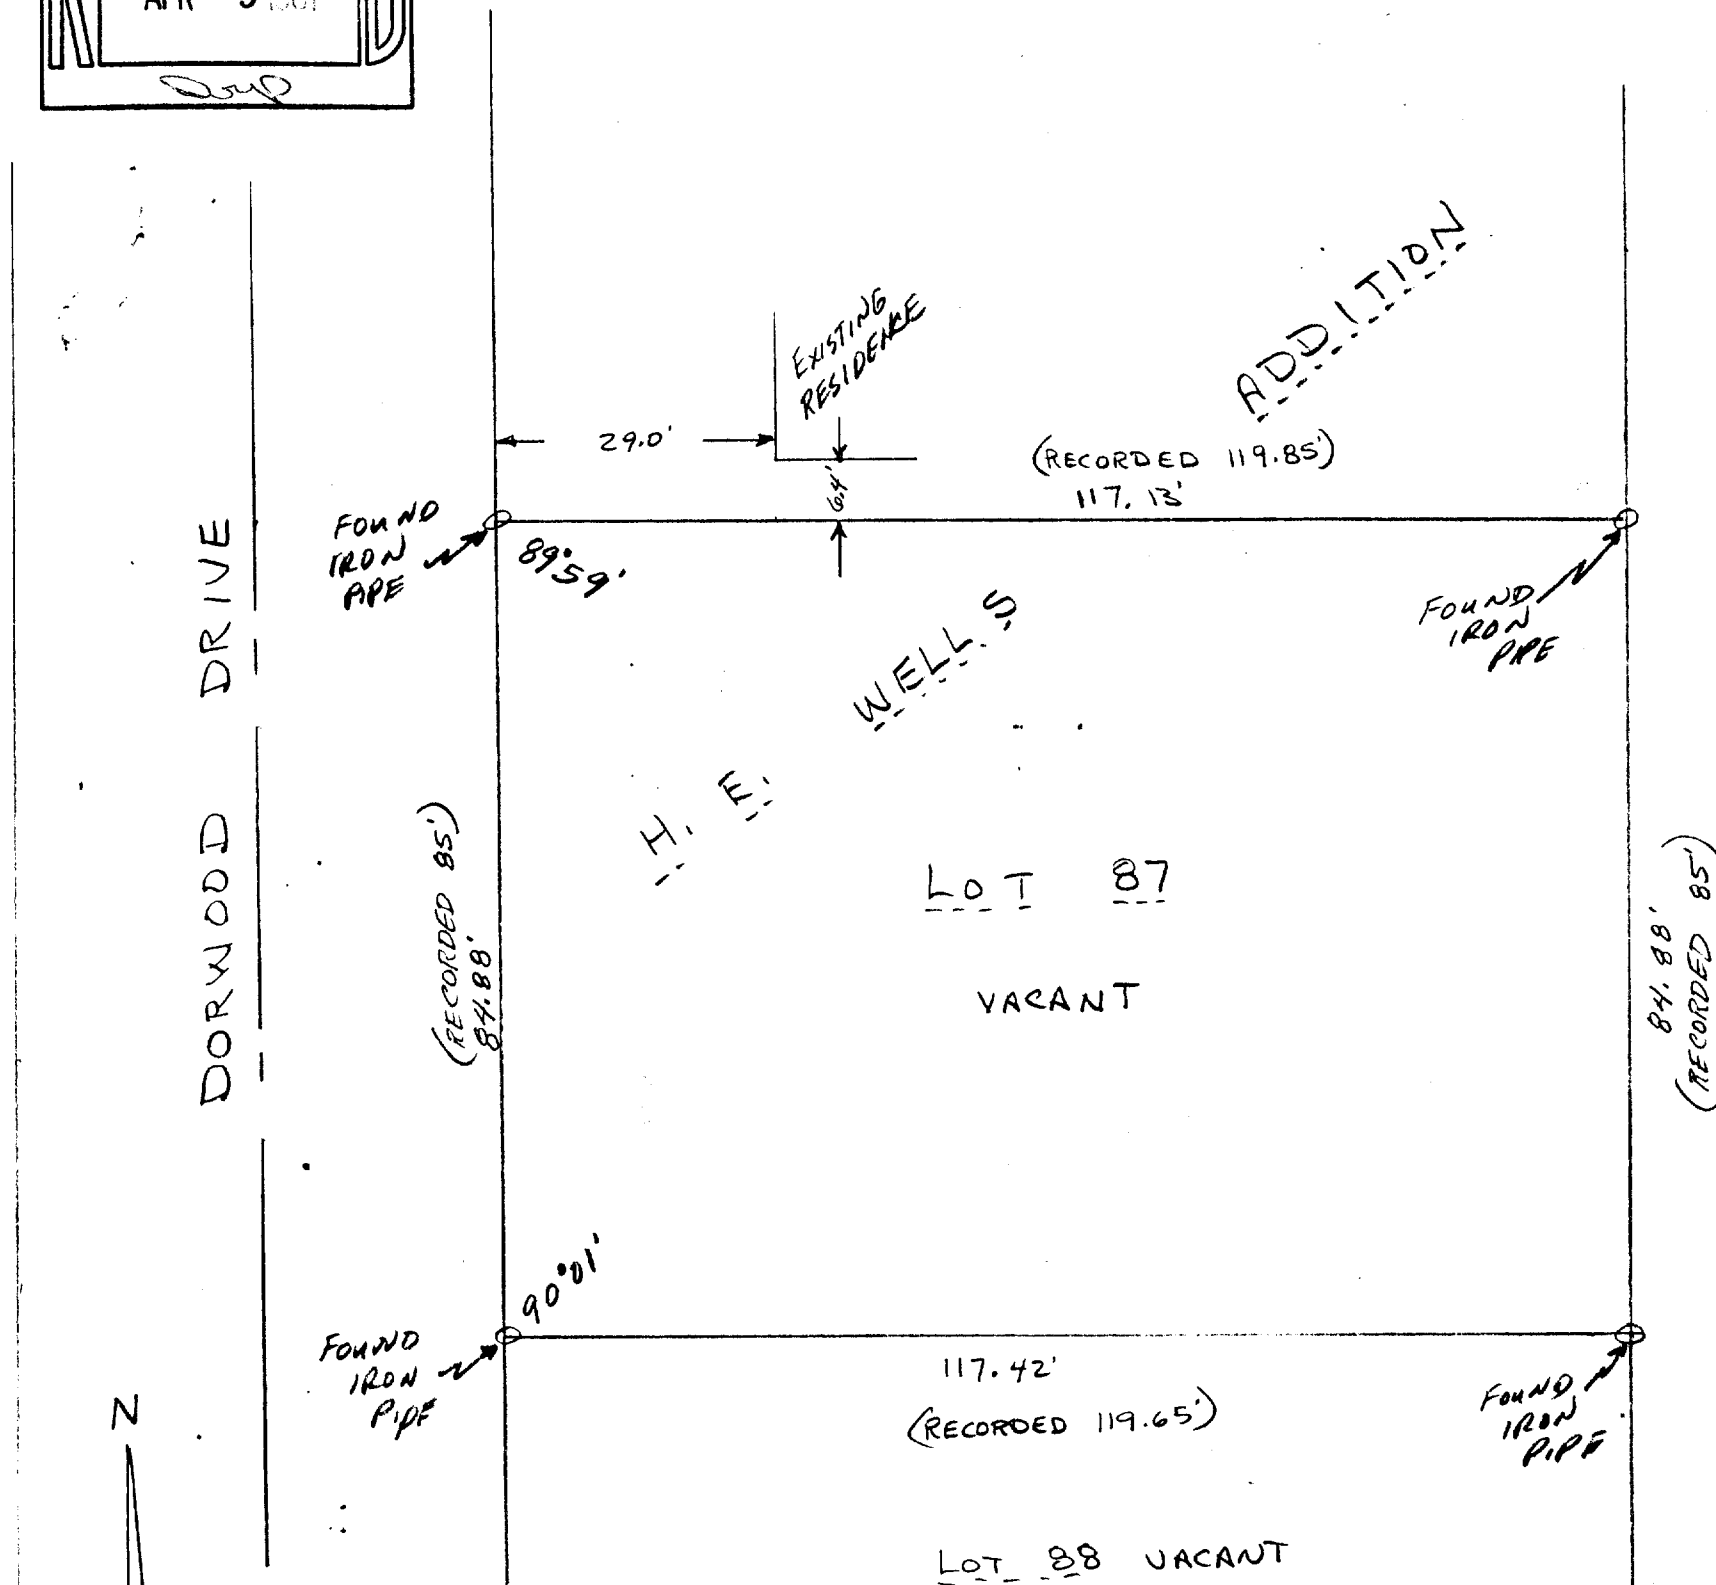

I hereby certify that I have surveyed the property described
hereon and that the above map is a true and accurate representation
thereof to the best of my professional knowledge and belief. .

Dated this 17 Day of March, 1987

Daniel D. Cooper, RLS No. S-1464

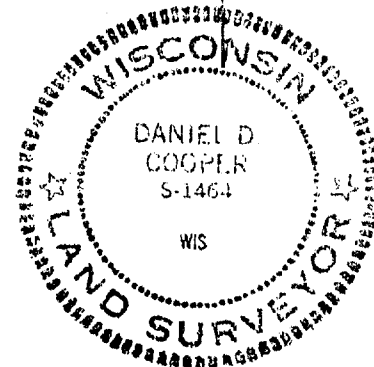

Survey ordered by Anthony
Zagotta