


WALWORTH COUNTY
SURVEYING & MAPPING
LAKE GENEVA, WISCONSIN



PLAT OF SURVEY OF
PART OF LOTS 8 AND 9, BLOCK 27 OF
THE ORIGINAL PLAT OF THE VILLAGE OF
GENEVA (NOW CITY OF LAKE GENEVA),
WALWORTH COUNTY, WISCONSIN.

ORDERED BY: CHARLES LOTH
747 WEST MAIN STREET
LAKE GENEVA, WISCONSIN

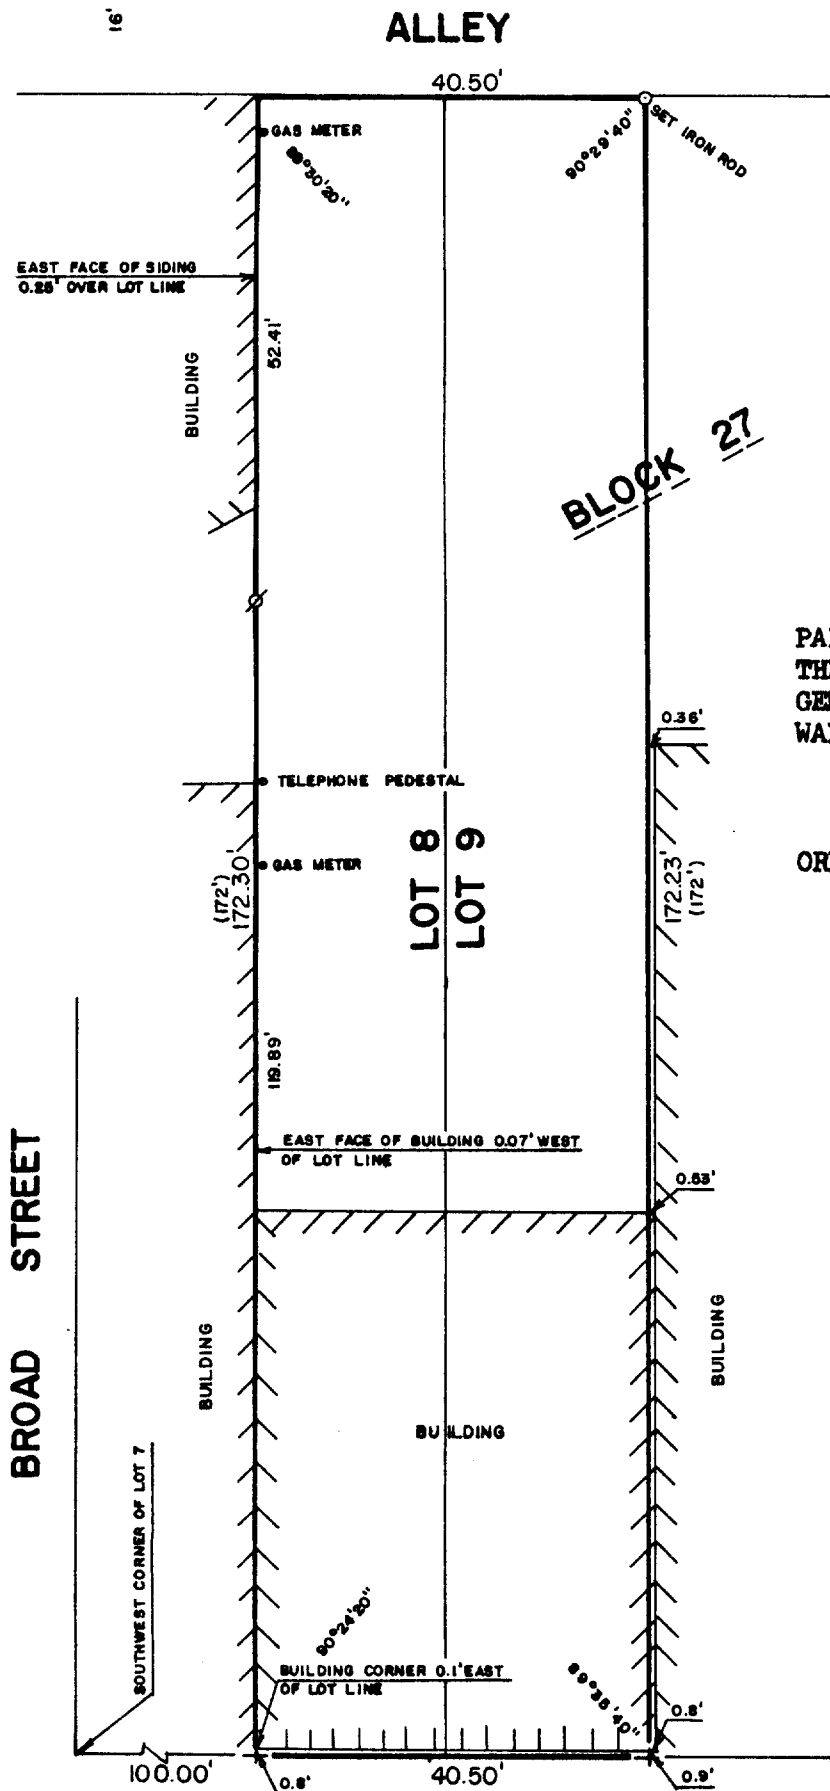

Ø - IRON ROD FOUND
+ - CUT CROSS IN CONCRETE
() - RECORDED AS

I, ROBERT M. BAERENWALD, DO HEREBY CERTIFY THAT I
HAVE SURVEYED THE PROPERTY HEREON DESCRIBED ACCORDING
TO THE OFFICIAL RECORDS AND THAT THE PLAT HEREON IS A
CORRECT REPRESENTATION OF THE PROPERTY LINES TO THE
BEST OF MY KNOWLEDGE AND BELIEF.

Robert M. Baerenwald
ROBERT M. BAERENWALD
WISCONSIN REGISTERED LAND SURVEYOR, S-1508

March 16, 1987
DATE JOB NO. 0956

NOTE: THIS IS NOT A CERTIFIED COPY UNLESS SEALED.