
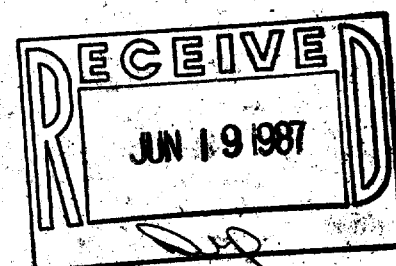
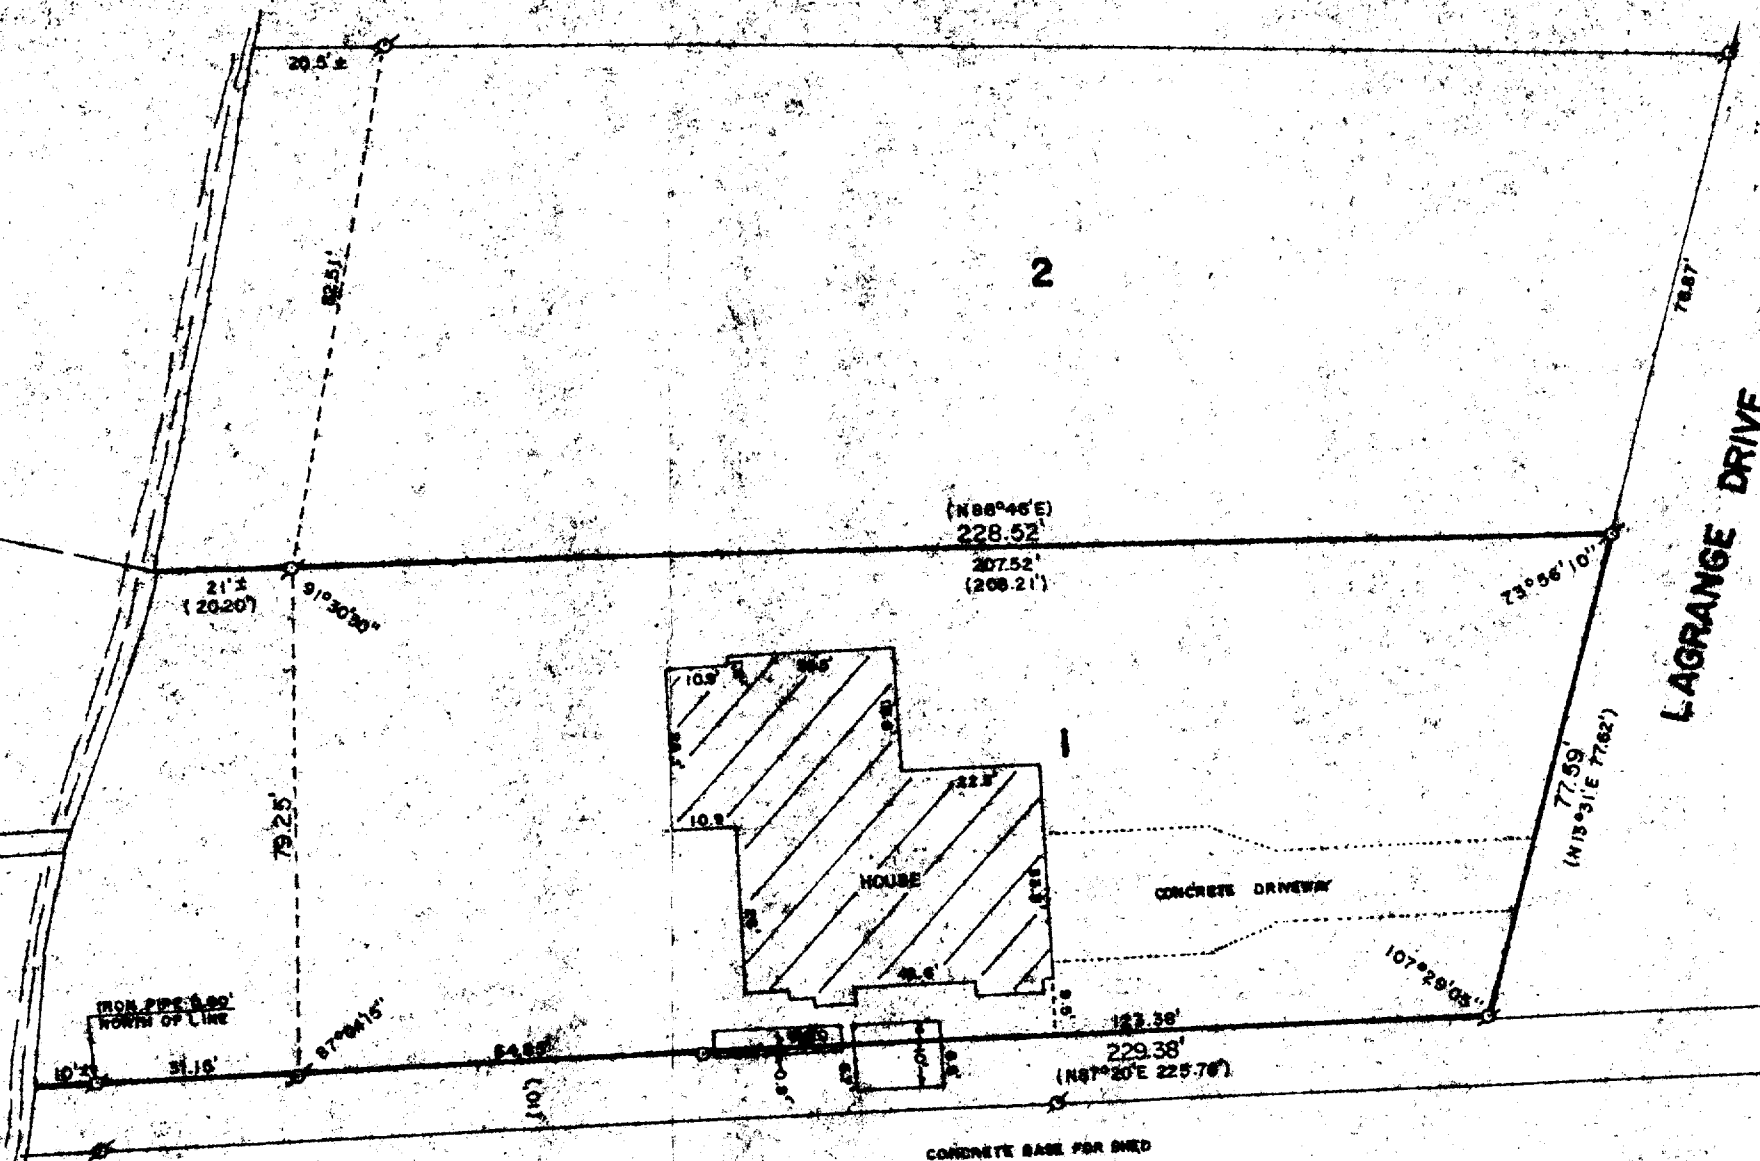


WALWORTH COUNTY
SURVEYING & MAPPING
LAKE GENEVA, WISCONSIN

RIPIARIAN INTEREST LINE

GENEVA LAKE

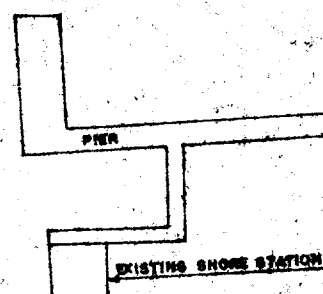

SCALE: 1"=30'

- ⊙ - IRON PIPE FOUND
- - IRON ROD PLACED
- () - RECORDED AS

PLAT OF SURVEY OF

LOT 1 OF LAKE GENEVA EAST SHORE ESTATES,
LOCATED IN THE CITY OF LAKE GENEVA, WALWORTH
COUNTY, WISCONSIN

ORDERED BY: NEAL HENDOLT
303 ROLLING WOOD LANE
JOLIET, ILLINOIS 60439

I, ROBERT M. BARNESWALD, DO HEREBY CERTIFY THAT I
HAVE SURVEYED THE PROPERTY HEREON DESCRIBED ACCORDING
TO THE OFFICIAL RECORDS AND THAT THE PLAT HEREON IS A
CORRECT REPRESENTATION OF THE PROPERTY LINES TO THE
BEST OF MY KNOWLEDGE AND BELIEF.

Robert M. Barneswald
ROBERT M. BARNESWALD
WISCONSIN REGISTERED LAND SURVEYOR, S-1508

DATE *May 17, 1987*
JOB NO. 0997