


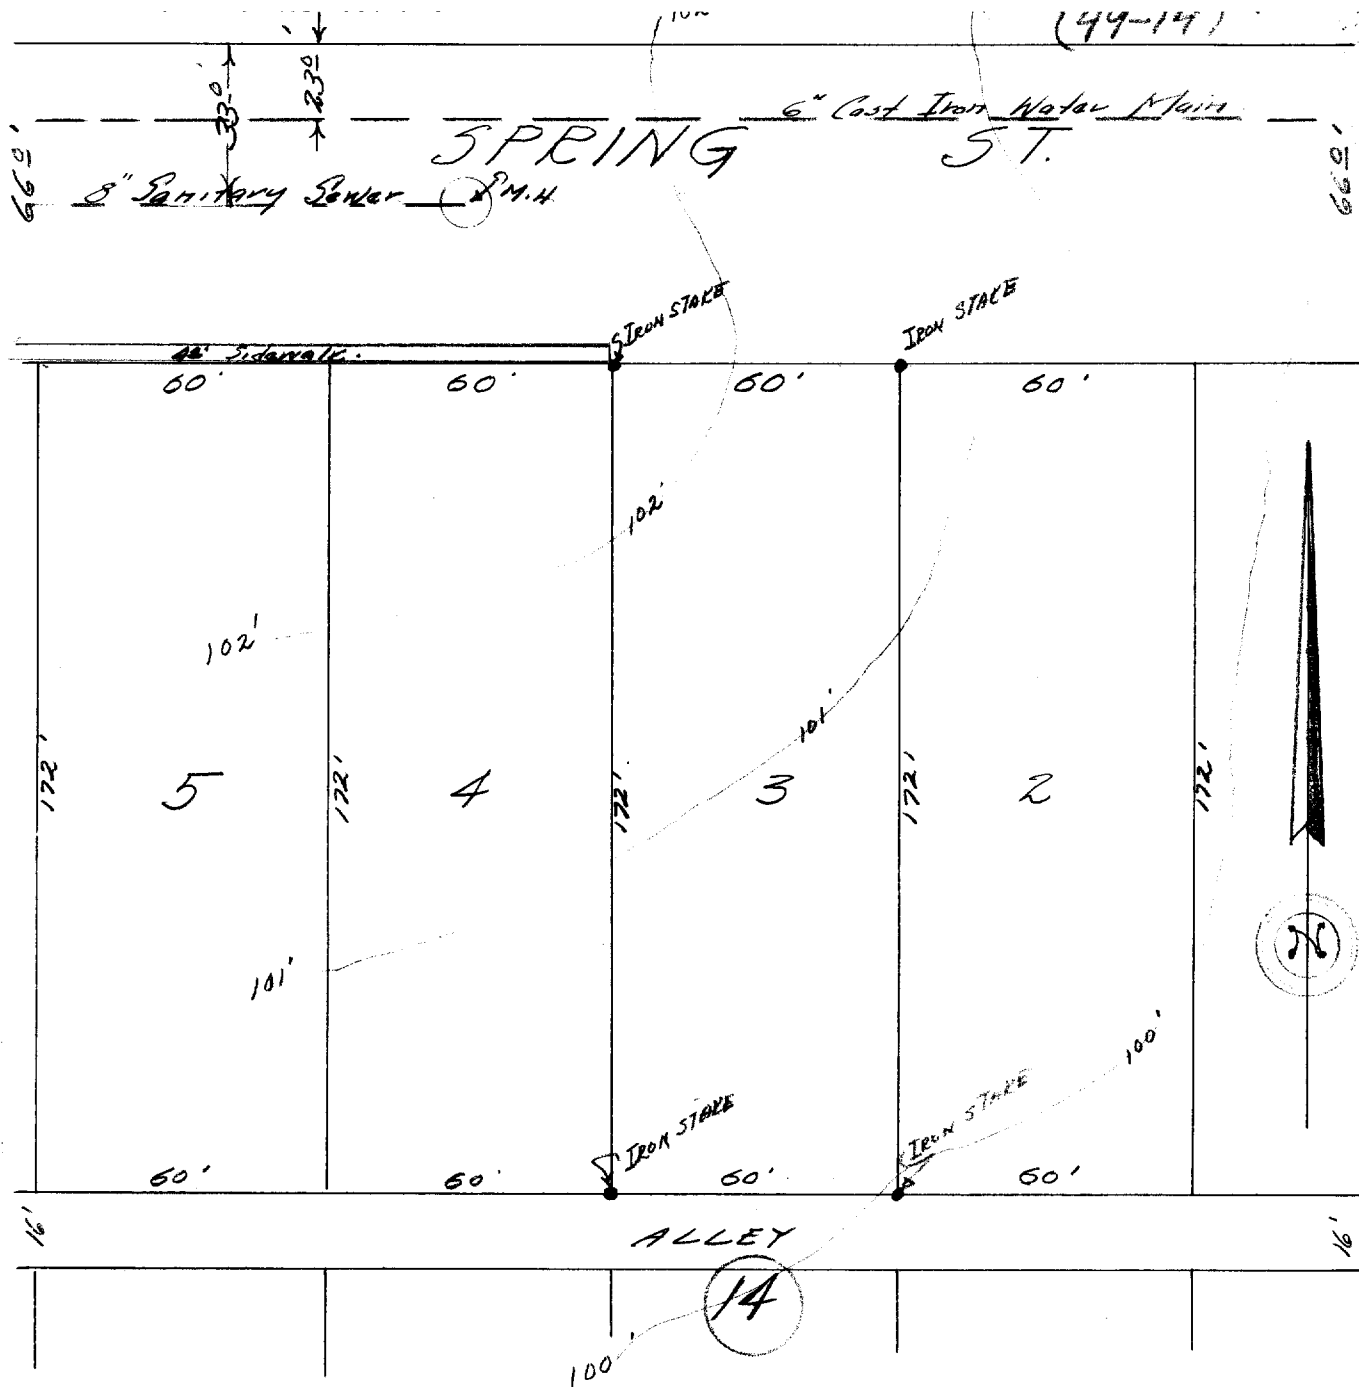

DESCRIPTION:

Lot 3 Block 14, Geneva Lake Crawford Manufacturers Company
Addition to the City of Lake Geneva Walworth County, Wisconsin.
STATE OF WISCONSIN)
WALWORTH COUNTY) SS

I, Joseph M. Biagi, do hereby certify that I have made the above survey according to official records; that the survey of the lot and the information relative to the utilities as shown on the above survey, is true and correct as indicated and marked on the above map.

Dated September 22 1949.

Joseph M. Biagi
Joseph M. Biagi.
Professional Engineer
State of Wisconsin.

7-93B