



WALWORTH COUNTY
SURVEYING & MAPPING
LAKE GENEVA, WISCONSIN

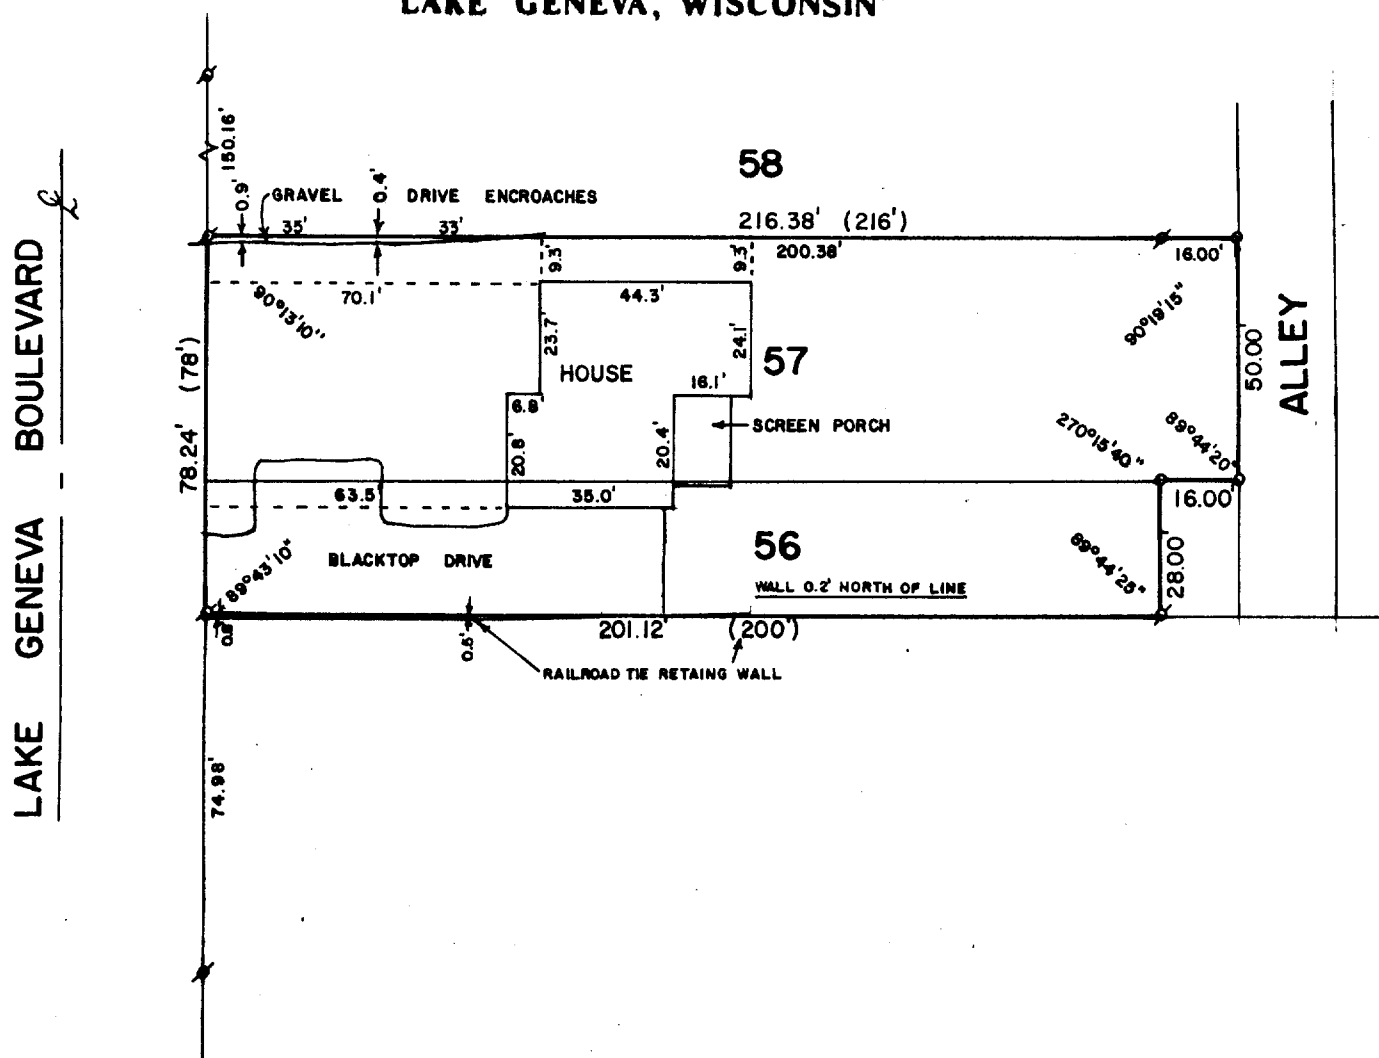


PLAT OF SURVEY OF

LOT 57 AND THE NORTH 28 FEET OF
LOT 56, BOULEVARD SUBDIVISION,
CITY OF LAKE GENEVA, WALWORTH
COUNTY, WISCONSIN, EXCEPTING
SIXTEEN (16) FEET OFF THE EAST
SIDE OF SAID PARCEL.

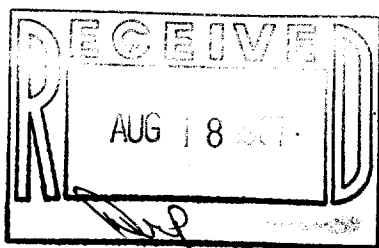

ORDERED BY: MIKE CARROLL
1159 LAKE GENEVA BOULEVARD
LAKE GENEVA, WISCONSIN 53147

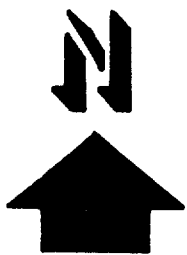

SCALE: 1"=40'

⊘ - IRON PIPE FOUND
○ - IRON ROD PLACED
() - RECORDED AS

I, ROBERT M. BAERENWALD, DO HEREBY CERTIFY THAT I
HAVE SURVEYED THE PROPERTY HEREON DESCRIBED ACCORDING
TO THE OFFICIAL RECORDS AND THAT THE PLAT HEREON IS A
CORRECT REPRESENTATION OF THE PROPERTY LINES TO THE
BEST OF MY KNOWLEDGE AND BELIEF.

Robert M. Baerenwald
ROBERT M. BAERENWALD
WISCONSIN REGISTERED LAND SURVEYOR, S-1508

DATE June 24, 1987
JOB NO. 1118

NOTE: THIS IS NOT A CERTIFIED COPY UNLESS SEALED.