


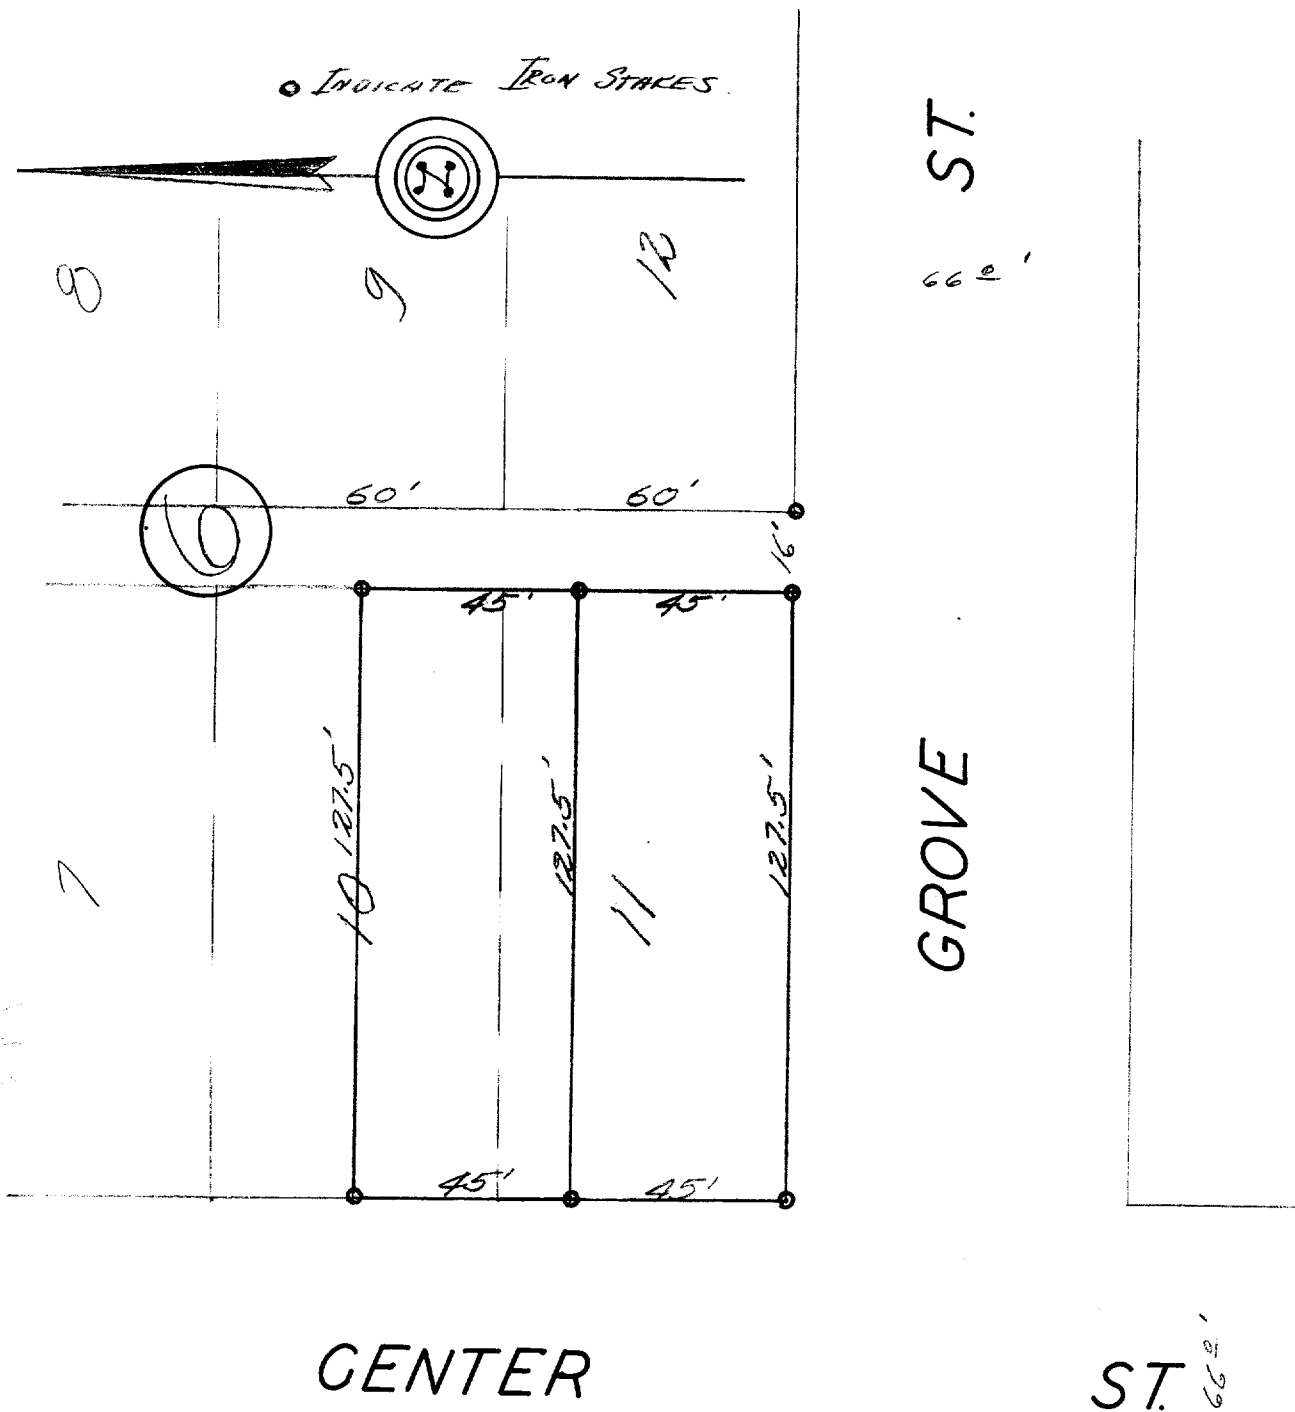

DESCRIPTION:

Parcel "A"

South 45 feet of Lot 11 Block 6; Geneva Lake Crawford Manufacturers Company Addition to the City of Lake Geneva Walworth County, Wisconsin.

Parcel "B"

The north 15 feet of Lot 11 Block 6 and the south 30 feet of Lot 10 Block 6; Geneva Lake Crawford Manufacturers Company Addition to the City of Lake Geneva, Walworth County Wisconsin.

CERTIFICATE:

I, hereby certify that I have on this the 22nd day of July 1949, surveyed the above described property, according to the official record on file in the office of the Recorder of Deeds in and for Walworth County, Wisconsin, and find that the measurements and bearings of the boundary lines of said property as taken at the site on this day, substantially agree with those in said official record and that no encroachments exist.

SIGNED AND SEALED ON THIS 27TH DAY OF JULY 1949.

Joseph M. Biagi
Joseph M. Biagi.
Professional Engineer
Elkhorn Wisconsin.