

WALWORTH COUNTY
SURVEYING & MAPPING
LAKE GENEVA, WISCONSIN

LAGRANGE DRIVE

(S89°26'45"E 160.03')

159.97'

10' WIDE EASEMENT

(S89°26'45"E 126.77')

(S89°26'45"E 6.17')

(10.43')

(21.70')


(N0°33'15"E 20.80')

(S44°26'45"E 33.06')

(2.69')

(S17°05'00"W 117.42')

(25' PUBLIC ROAD OR PRIVATE
EASEMENT OR RIGHT-OF-WAY)

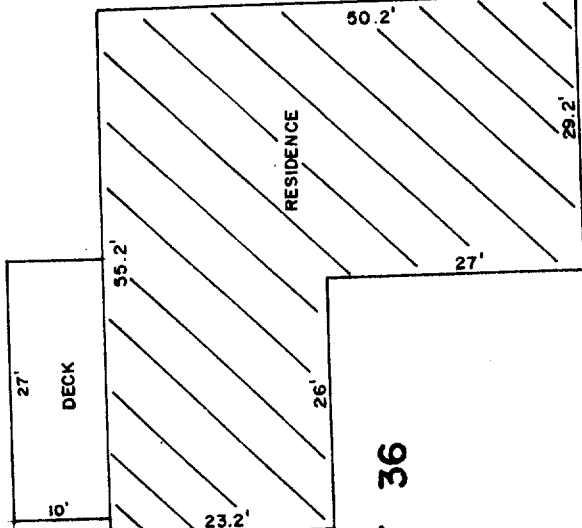

UNIT 36

HEATHER RIDGE ROAD

(N75°16'01"W 64.50')


(N02°45'00"E 189.97')

(N81°51'36.5"W 52.33')
(R=227.88')

(N88°27'12"W 12.22')

89.56'
(N0°33'15"E 89.65')

PLAT OF SURVEY OF

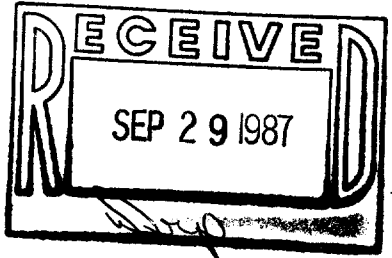

UNIT 36 OF SOMMERSET CONDOMINIUM, BEING PART
OF GREENRIDGE DOWNS IN THE CITY OF LAKE GENEVA,
WALWORTH COUNTY, WISCONSIN.

ORDERED BY: SONTAG REALTY
RT. 1, P. O. BOX 360
LAKE GENEVA, WISCONSIN 53147



SCALE: 1"=20'

σ - IRON PIPE FOUND
σ - IRON ROD FOUND
() - RECORDED AS

I, ROBERT M. BAERENWALD, DO HEREBY CERTIFY THAT I
HAVE SURVEYED THE PROPERTY HEREON DESCRIBED ACCORDING
TO THE OFFICIAL RECORDS AND THAT THE PLAT HEREON IS A
CORRECT REPRESENTATION OF THE PROPERTY LINES TO THE
BEST OF MY KNOWLEDGE AND BELIEF.

Robert M. Baerenwald
ROBERT M. BAERENWALD
WISCONSIN REGISTERED LAND SURVEYOR, S-1508

DATE July 22, 1987 JOB NO. 0076-1

NOTE: THIS IS NOT A CERTIFIED COPY UNLESS SEALED.

ZCNS-36

7-956