



BAY VIEW DRIVE

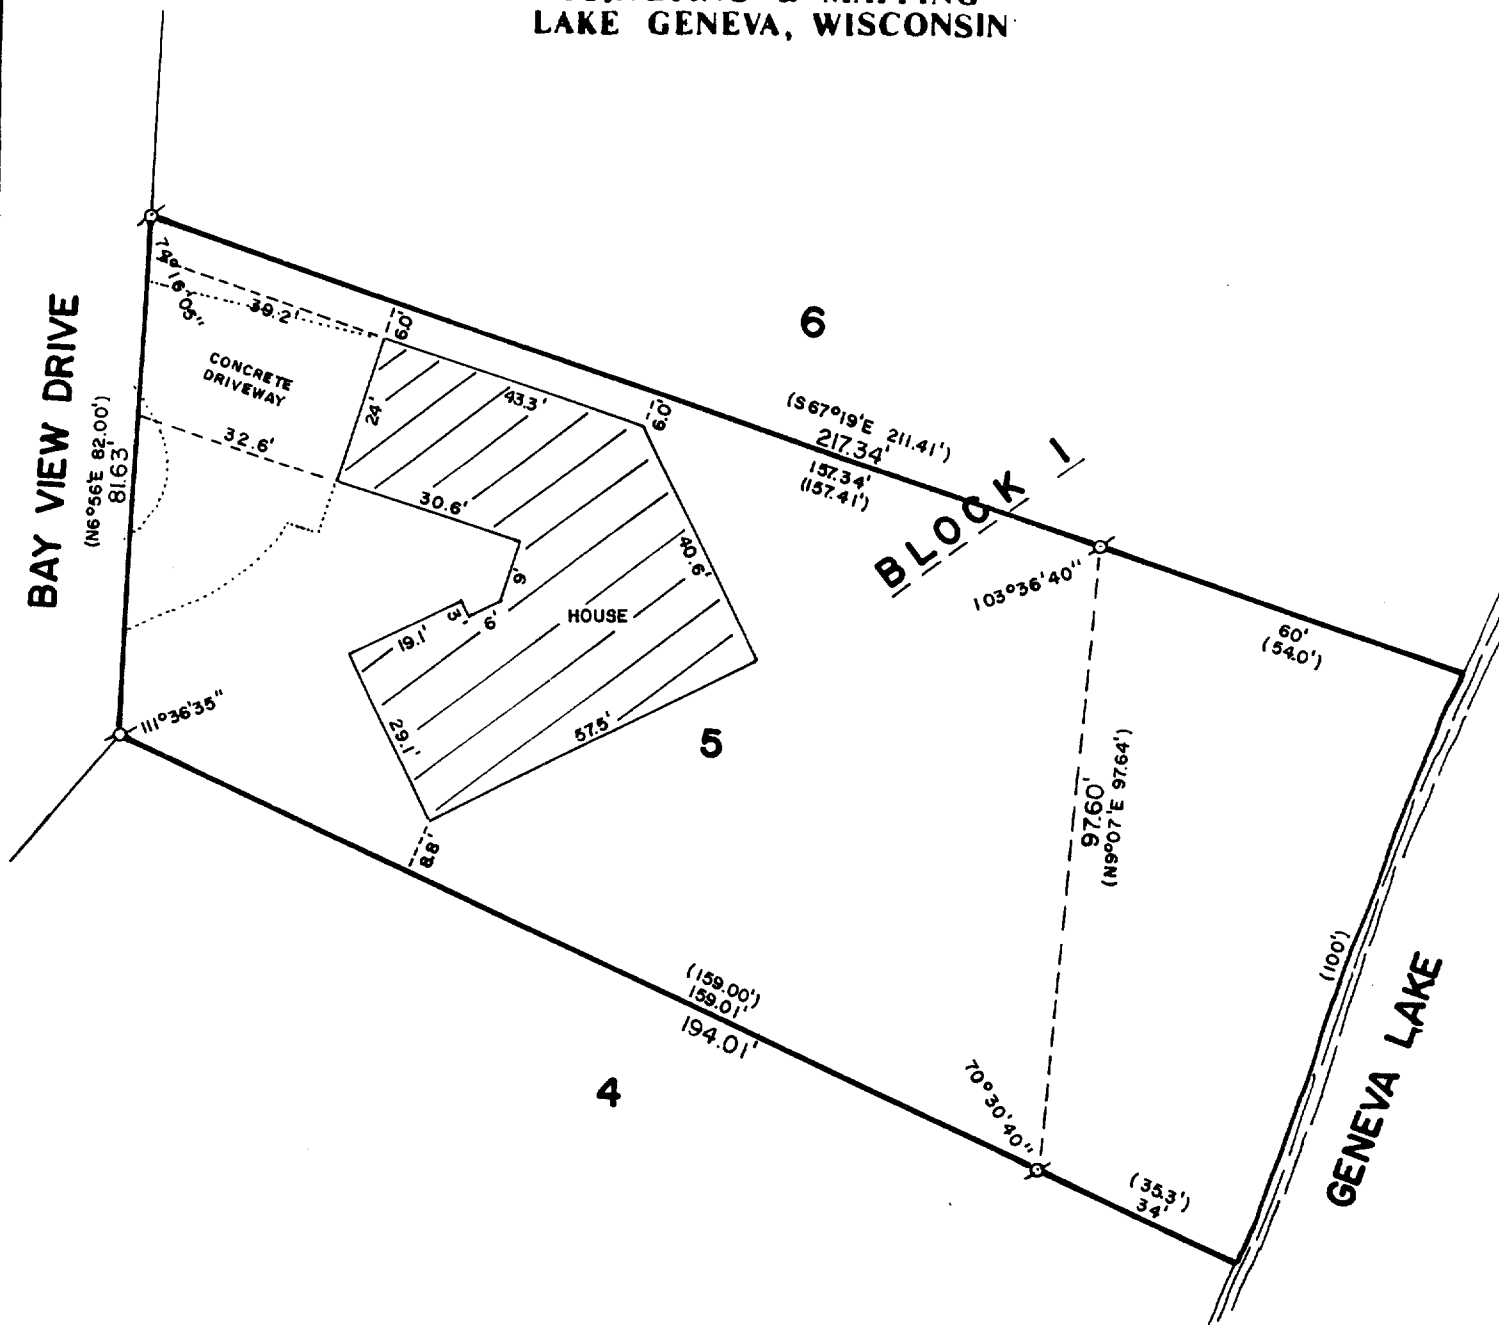

LOT 5, BLOCK 1 OF GENEVA BAY ESTATES,
LOCATED IN THE CITY OF LAKE GENEVA,
WALWORTH COUNTY, WISCONSIN.

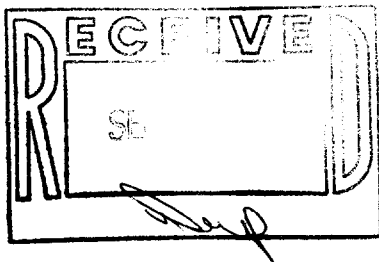

ORDERED BY: CHARLES SAWALL
7001 N. KEYSTONE
LINCOLNWOOD, ILLINOIS
60646



σ-IRON PIPE FOUND
()-RECORDED AS

Robert M. Baerenwald
ROBERT M. BAERENWALD
WISCONSIN REGISTERED LAND SURVEYOR, S-1508

DATE Sept. 12, 1986 JOB NO. 1230

NOTE: THIS IS NOT A CERTIFIED COPY UNLESS SEALED.